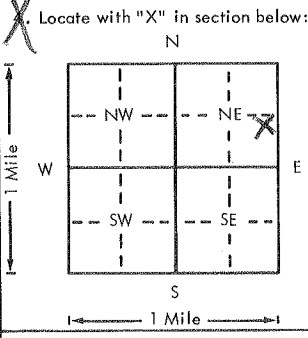


USE TYPEWRITER OR BALL POINT PEN-PRESS FIRMLY, PRINT CLEARLY.

WATER WELL RECORD
KSA 82a-1201-1215

Kansas Department of Health and Environment-Division of Environment (Water well Contractors) Topeka, Kansas 66620

1. Location of well:	County Dickinson	Fraction NE 1/4 SE 1/4 NE 1/4	Section number 6	Township number T 13 S R 2	Range number 2 (E/W)
2. Distance and direction from nearest town or city: 3 miles north west of Abilene			3. Owner of well: Lowell Riker R.R. or street: R.R. # 4 City, state, zip code: Abilene, Kansas 67410		
X Locate with "X" in section below: 		Sketch map:		6. Bore hole dia. 8 in. Completion date _____ Well depth 63 ft. 2/9/77	
				7. <input type="checkbox"/> Cable tool <input checked="" type="checkbox"/> Rotary <input type="checkbox"/> Driven <input type="checkbox"/> Dug <input type="checkbox"/> Hollow rod <input type="checkbox"/> Jetted <input type="checkbox"/> Bored <input type="checkbox"/> Reverse rotary	
				8. Use: <input checked="" type="checkbox"/> Domestic <input type="checkbox"/> Public supply <input type="checkbox"/> Industry <input type="checkbox"/> Irrigation <input type="checkbox"/> Air conditioning <input type="checkbox"/> Stock <input type="checkbox"/> Lawn <input type="checkbox"/> Oil field water <input type="checkbox"/> Other	
				9. Casing: Material plst Height: Above or below Threaded _____ Welded pl Surface 18 in. RMP <input checked="" type="checkbox"/> PVC _____ Weight _____ lbs./ft. Dia. 5 in. to 63 ft. depth Wall Thickness: inches or Dia. _____ in. to _____ ft. depth gage No. 0.258	
5. Type and color of material		From	To	10. Screen: Manufacturer's name Western Plastics	
Top soil		0	3	Type RMP Dia. 5 1/2 Slot/gauze 3/32 Length 20' Set between 43 ft. and 63 ft. _____ ft. and _____ ft.	
Soft limestone		3	28	Gravel pack? Yes Size range of material 1/16 to 3/8	
Lost circulation, mostly red clay and shale		28	63	11. Static water level: 25 ft. below land surface Date 2/9/77 mo./day/yr.	
				12. Pumping level below land surfaces: _____ ft. after _____ hrs. pumping _____ g.p.m. _____ ft. after _____ hrs. pumping _____ g.p.m. Estimated maximum yield 15 g.p.m.	
				13. Water sample submitted: _____ mo./day/yr. <input type="checkbox"/> Yes <input checked="" type="checkbox"/> No Date _____	
				14. Well head completion: <input type="checkbox"/> Pitless adapter 18 Inches above grade	
				<input checked="" type="checkbox"/> Well grouted? Yes With: <input checked="" type="checkbox"/> Neat cement <input type="checkbox"/> Bentonite <input type="checkbox"/> Concrete Depth: From 0 ft. to 10 ft.	
				16. Nearest source of possible contamination: ft. 55 Direction SE Type Sewer Well disinfected upon completion? <input checked="" type="checkbox"/> Yes _____ No	
				17. Pump: <input checked="" type="checkbox"/> Not installed Manufacturer's name _____ Model number _____ HP _____ Volts _____ Length of drop pipe _____ ft. capacity _____ g.p.m. Type: <input type="checkbox"/> Submersible <input type="checkbox"/> Turbine <input type="checkbox"/> Jet <input type="checkbox"/> Reciprocating <input type="checkbox"/> Centrifugal <input type="checkbox"/> Other	
		(Use a second sheet if needed)			
18. Elevation:		19. Remarks:		20. Water well contractor's certification: This well was drilled under my jurisdiction and this report is true to the best of my knowledge and belief. Rader Drilling Co. 194 Business name License No. _____ Address Carlton, Kans. 67429 Signed Bruce E. Rader Date 2-8-77 Authorized representative	
Topography: <input type="checkbox"/> Hill <input type="checkbox"/> Slope <input type="checkbox"/> Upland <input type="checkbox"/> Valley					

T 13 S R 2 E
Sec 6 - NE SE NE