


1 LOCATION OF WATER WELL: County: Dickinson Fraction: SW 1/4 SW 1/4 SW 1/4 Section Number: 8 Township Number: T 13 S Range Number: R 2 E/W

Distance and direction from nearest town or city street address of well if located within city?
At Abilene, Ks on Hwy 15 & Hwy 40 Jct. go 1/2 mile West North side

2 WATER WELL OWNER: Jon D. Thayer
 RR#, St. Address, Box #: 1100 N. Buckeye Board of Agriculture, Division of Water Resources
 City, State, ZIP Code: Abilene, Kansas 67410 Application Number:

3 LOCATE WELL'S LOCATION WITH AN "X" IN SECTION BOX:

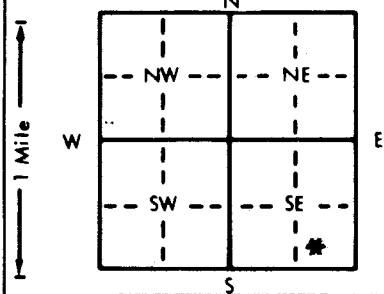

4 DEPTH OF COMPLETED WELL: 60 ft. ELEVATION:
 Depth(s) Groundwater Encountered 1. 37 ft. 2. ft. 3. ft.
 WELL'S STATIC WATER LEVEL: 28 ft. below land surface measured on mo/day/yr 9 / 17 / 92
 Pump test data: Well water was ft. after hours pumping gpm
 Est. Yield: 30 gpm Well water was ft. after hours pumping gpm
 Bore Hole Diameter: 9 in. to 60 ft., and in. to ft.
 WELL WATER TO BE USED AS:
 1 Domestic 3 Feedlot 6 Oil field water supply 9 Dewatering 12 Other (Specify below)
 2 Irrigation 4 Industrial 7 Lawn and garden only 10 Monitoring well
 Was a chemical/bacteriological sample submitted to Department? Yes No * If yes, mo/day/yr sample was submitted Water Well Disinfected? Yes * No

5 TYPE OF BLANK CASING USED:
 1 Steel 3 RMP (SR) 5 Wrought iron 8 Concrete tile CASING JOINTS: Glued * Clamped
 2 PVC 4 ABS 6 Asbestos-Cement 9 Other (specify below) Welded
 7 Fiberglass Threaded
 Blank casing diameter: 5 in. to 60 ft. Dia. in. to ft. Dia. in. to ft.
 Casing height above land surface: 16 in., weight 160 lbs./ft. Wall thickness or gauge No. 21 1/2

TYPE OF SCREEN OR PERFORATION MATERIAL:
 1 Steel 3 Stainless steel 5 Fiberglass 8 RMP (SR) 10 Asbestos-cement
 2 Brass 4 Galvanized steel 6 Concrete tile 9 ABS 11 Other (specify)
 12 None used (open hole)
 SCREEN OR PERFORATION OPENINGS ARE:
 1 Continuous slot 3 Mill slot 5 Gauzed wrapped 8 Saw cut 11 None (open hole)
 2 Louvered shutter 4 Key punched 6 Wire wrapped 9 Drilled holes
 7 Torch cut 10 Other (specify)
 SCREEN-PERFORATED INTERVALS: From 32 ft. to 60 ft., From ft. to ft.
 From ft. to ft., From ft. to ft.
 GRAVEL PACK INTERVALS: From 23 ft. to 60 ft., From ft. to ft.
 From ft. to ft., From ft. to ft.

6 GROUT MATERIAL: 1 Neat cement 2 Cement grout 3 Bentonite 4 Other
 Grout Intervals: From 3 ft. to 23 ft., From ft. to ft., From ft. to ft.
 What is the nearest source of possible contamination:
 1 Septic tank 4 Lateral lines 7 Pit privy 10 Livestock pens 14 Abandoned water well
 2 Sewer lines 5 Cess pool 8 Sewage lagoon 11 Fuel storage 15 Oil well/Gas well
 3 Watertight sewer lines 6 Seepage pit 9 Feedyard 12 Fertilizer storage 16 Other (specify below)
 13 Insecticide storage
 Direction from well? NORTHWEST WILL BE How many feet? approx 150

FROM	TO	LITHOLOGIC LOG	FROM	TO	PLUGGING INTERVALS
0	3	BROWN SANDY CLAY			
3	11	LITE COLOR SHALE & CLAY			
11	17	TAN COLOR LIMESTONE			
17	19	GRAY SHALE & CLAY			
19	23	GRAY RED & MIXED SHALE			
23	37	DARK RED SHALE			
37	39	LITE COLOR SHALE & CLAY			
39	51	LITE COLOR LIMESTONE			
51	58	GRAY HARD LIMESTONE			
58	60	TAN COLOR HARD LIMESTONE			

7 CONTRACTOR'S OR LANDOWNER'S CERTIFICATION: This water well was (1) constructed, (2) reconstructed, or (3) plugged under my jurisdiction and was completed on (mo/day/year) 9 / 17 / 92 and this record is true to the best of my knowledge and belief. Kansas Water Well Contractor's License No. 397 This Water Well Record was completed on (mo/day/yr) 9 / 27 / 92 under the business name of CENTRAL KANSAS DRILLING by (signature) Harold R. Martin

INSTRUCTIONS: Use typewriter or ball point pen. PLEASE PRESS FIRMLY and PRINT clearly. Please fill in blanks, underline or circle the correct answers. Send top three copies to Kansas Department of Health and Environment, Bureau of Water, Topeka, Kansas 66620-0001. Telephone: 913-296-5545. Send one to WATER WELL OWNER and retain one for your records.

861000