


1] LOCATION OF WATER WELL: Fraction NW 1/4 SE 1/4 SE 1/4 Section Number 9 Township Number T 13 S Range Number R 2 E/W
 County: Dickinson

Distance and direction from nearest town or city street address of well if located within city?
Well located at 308 N. W. 17th in city of Abilene, Kansas

2] WATER WELL OWNER: Don Nebelsick
 RR#, St. Address, Box # : 308 N. W. 17th
 City, State, ZIP Code : Abilene, Kansas 67410
 Board of Agriculture, Division of Water Resources
 Application Number:

3] LOCATE WELL'S LOCATION WITH AN "X" IN SECTION BOX: 4] DEPTH OF COMPLETED WELL: 64 ft. ELEVATION:
 Depth(s) Groundwater Encountered 1. 44 ft. 2. ft. 3. ft.

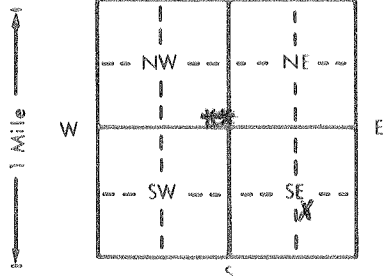

WELL'S STATIC WATER LEVEL 35 ft. below land surface measured on 5/4/85
 Pump test data: Well water was ft. after hours pumping gpm
 Est. Yield 25+ gpm: Well water was ft. after hours pumping gpm
 Bore Hole Diameter 9 in. to 64 ft., and in. to ft.
 WELL WATER TO BE USED AS: 5 Public water supply 8 Air conditioning 11 Injection well
 1 Domestic 3 Feedlot 6 Oil field water supply 9 Dewatering 12 Other (Specify below)
 2 Irrigation 4 Industrial 7 Lawn and garden only 10 Observation well
 Was a chemical/bacteriological sample submitted to Department? Yes.....No...*.....; If yes, mo/day/yr sample was submitted
 Water Well Disinfected? Yes * No

5] TYPE OF BLANK CASING USED: 5 Wrought iron 8 Concrete tile CASING JOINTS: Glued * Clamped
 1 Steel 3 RMP (SR) 6 Asbestos-Cement 9 Other (specify below) Welded
 2 PVC 4 ABS 7 Fiberglass Threaded.....

Blank casing diameter 5 in. to 64 ft., Dia in. to ft.
 Casing height above land surface 14 in., weight 160 lbs./ft. Wall thickness or gauge No. .214

TYPE OF SCREEN OR PERFORATION MATERIAL: 7 PVC 10 Asbestos-cement
 1 Steel 3 Stainless steel 5 Fiberglass 8 RMP (SR) 11 Other (specify)
 2 Brass 4 Galvanized steel 6 Concrete tile 9 ABS 12 None used (open hole)

SCREEN OR PERFORATION OPENINGS ARE: 5 Gauzed wrapped 8 Saw cut 11 None (open hole)
 1 Continuous slot 3 Mill slot 6 Wire wrapped 9 Drilled holes
 2 Louvered shutter 4 Key punched 7 Torch cut 10 Other (specify)

SCREEN-PERFORATED INTERVALS: From 40 ft. to 64 ft., From ft. to ft.
 GRAVEL PACK INTERVALS: From 13 ft. to 16 ft., From ft. to ft.

6] GROUT MATERIAL: 1 Neat cement 2 Cement grout 3 Bentonite 4 Other
 Grout Intervals: From 3 ft. to 13 ft., From ft. to ft.

What is the nearest source of possible contamination:
 1 Septic tank 4 Lateral lines 7 Pit privy 10 Livestock pens 14 Abandoned water well
 2 Sewer lines 5 Cess pool 8 Sewage lagoon 11 Fuel storage 15 Oil well/Gas well
 3 Watertight sewer lines 6 Seepage pit 9 Feedyard 12 Fertilizer storage 16 Other (specify below)
 13 Insecticide storage

Direction from well? South How many feet? 94

FROM	TO	LITHOLOGIC LOG	FROM	TO	LITHOLOGIC LOG
0	8	Brown clay			
8	13	Limestone			
13	20	Lite color shale & clay			
20	26	Hard limestone			
26	27	Green shale			
27	31	Lite color shale			
31	39	Red shale			
39	44	Lite gray shale			
44	47	Lite color shale & limestone			
47	61	Hard limestone			
61	64	Dark limestone & flint			

7] CONTRACTOR'S OR LANDOWNER'S CERTIFICATION: This water well was (1) constructed, (2) reconstructed, or (3) plugged under my jurisdiction and was completed on (mo/day/year) 5/4/85 and this record is true to the best of my knowledge and belief. Kansas Water Well Contractor's License No. 397 This Water Well Record was completed on (mo/day/yr) 6/14/85 under the business name of CENTRAL KANSAS DRILLING by (signature) Arnold D. Martin

INSTRUCTIONS: Use typewriter or ball point pen, PLEASE PRESS FIRMLY and PRINT clearly. Please fill in blanks, underline or circle the correct answers. Send top three copies to Kansas Department of Health and Environment, Division of Environment, Environmental Geology Section, Topeka, KS 66620. Send one to WATER WELL OWNER and retain one for your records.

840378863