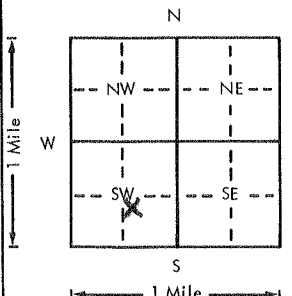
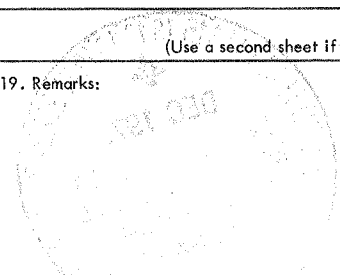


USE TYPEWRITER OR BALL POINT PEN-PRESS FIRMLY, PRINT CLEARLY.

WATER WELL RECORD
KSA 82a-1201-1215

Kansas Department of Health and Environment-Division of Environment (Water well Contractors)
Topeka, Kansas 66620

1. Location of well:	County Dickinson	Fraction NW 1/4 SE 1/4 SW 1/4	Section number 9	Township number T 13 S	Range number R 2 EW	
2. Distance and direction from nearest town or city: Street address of well location if in city: 1700 Beekman Place Abilene, Kans.			3. Owner of well: O. B. Bradley R.R. or street: 1700 Beekman Place City, state, zip code: Abilene, Kansas 67410			
4. Locate with "X" in section below: <div style="text-align: center;">  </div>			Sketch map:			
5. Type and color of material			From	To	6. Bore hole dia. <u>8</u> in. Completion date: <u>2-13-76</u> Well depth <u>64</u> ft.	
Brown clay			0	12	7. <input type="checkbox"/> Cable tool <input checked="" type="checkbox"/> Rotary <input type="checkbox"/> Driven <input type="checkbox"/> Dug <input type="checkbox"/> Hollow rod <input type="checkbox"/> Jetted <input type="checkbox"/> Bored <input type="checkbox"/> Reverse rotary	
Yellow clay			12	14	8. Use: <input type="checkbox"/> Domestic <input type="checkbox"/> Public supply <input type="checkbox"/> Industry <input checked="" type="checkbox"/> Irrigation <input type="checkbox"/> Air conditioning <input type="checkbox"/> Stock <input type="checkbox"/> Lawn <input type="checkbox"/> Oil field water <input type="checkbox"/> Other	
Hard limestone			14	16	9. Casing: Material <u>1st</u> Height <u>Above</u> or below Threaded <input type="checkbox"/> Welded <input checked="" type="checkbox"/> Surface <u>18</u> in. RMP <input type="checkbox"/> PVC <input checked="" type="checkbox"/> Weight <u> </u> lbs./ft. Dia. <u>5</u> in. to <u>64</u> ft. depth Wall Thickness: inches or Dia. <u> </u> in. to <u> </u> ft. depth gage No. <u>0.214</u>	
Green shale			16	20	10. Screen: Manufacturer's name <u>Western Plastics</u> Type <u>PVC</u> Dia. <u>5"</u> Slot gauze <u>3/32</u> Length <u>40'</u> Set between <u>24</u> ft. and <u>64</u> ft. Gravel pack? <u>yes</u> Size range of material <u>1/4 to 1/8</u>	
Red shale and clay			20	35	11. Static water level: <u>27'</u> ft. below land surface Date <u>2-13-76</u> mo./day/yr.	
Caly and buff rock			35	37	12. Pumping level below land surfaces: <u> </u> ft. after <u> </u> hrs. pumping <u> </u> g.p.m. <u> </u> ft. after <u> </u> hrs. pumping <u> </u> g.p.m. Estimated maximum yield <u>10</u> g.p.m.	
Limestone			37	45	13. Water sample submitted: <u> </u> mo./day/yr. <input type="checkbox"/> Yes <input checked="" type="checkbox"/> No Date <u> </u>	
Hard gray shale			45	64	14. Well head completion: <u>18</u> inches above grade <input type="checkbox"/> Pitless adapter	
					15. Well grouted? <u>yes</u> With: <input checked="" type="checkbox"/> Neat cement <input type="checkbox"/> Bentonite <input type="checkbox"/> Concrete Depth: From <u>0</u> ft. to <u>10</u> ft.	
					16. Nearest source of possible contamination: <u>IRRIO</u> ft. <u> </u> Direction <u> </u> Type <u>WELL</u> Well disinfected upon completion? <input checked="" type="checkbox"/> Yes <input type="checkbox"/> No	
					17. Pump: <input checked="" type="checkbox"/> Not installed Manufacturer's name <u> </u> Model number <u> </u> HP <u> </u> Volts <u> </u> Length of drop pipe <u> </u> ft. capacity <u> </u> g.p.m. Type: <input type="checkbox"/> Submersible <input type="checkbox"/> Turbine <input type="checkbox"/> Jet <input type="checkbox"/> Reciprocating <input type="checkbox"/> Centrifugal <input type="checkbox"/> Other	
(Use a second sheet if needed)						
18. Elevation: Topography: <input type="checkbox"/> Hill <input type="checkbox"/> Slope <input type="checkbox"/> Upland <input type="checkbox"/> Valley		19. Remarks: <div style="text-align: center;"></div>		20. Water well contractor's certification: This well was drilled under my jurisdiction and this report is true to the best of my knowledge and belief. <u>Rader Drilling Co.</u> 194 Business name License No. <u> </u> Address <u>Carlton, Kans. 67429</u> Signed <u>Bruce E. Rader</u> Date <u>2-17-76</u> Authorized representative		

13-29-76
R-29
W-29
Sec 9
1/4 1/4 1/4 1/4
NWSESW