


LOCATION OF WATER WELL: Fraction NE 1/4 NE 1/4 NE 1/4 Section Number 9 Township Number T 13 S Range Number R 2 E
 County: Dickinson

Distance and direction from nearest town or city street address of well if located within city?
1/2 mile East on Hwy 40-15 Jct 3/4 North & 1/4 West at Abilene, Ks

WATER WELL OWNER: Don Bartley
 RR#, St. Address, Box #: Rt 1 Board of Agriculture, Division of Water Resources
 City, State, ZIP Code: Abilene, Kansas 67410 Application Number:

LOCATE WELL'S LOCATION WITH AN "X" IN SECTION BOX: DEPTH OF COMPLETED WELL: 97 ft. ELEVATION:

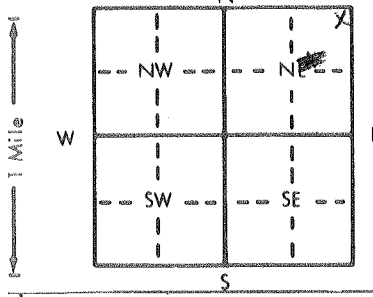

Depth(s) Groundwater Encountered 1. 73 ft. 2. ft. 3. ft.
 WELL'S STATIC WATER LEVEL .. 64 ft. below land surface measured on mo/day/yr 6 / 7 / 88
 Pump test data: Well water was ft. after hours pumping gpm
 Est. Yield .. 13 gpm: Well water was ft. after hours pumping gpm
 Bore Hole Diameter .. 9 in. to 97 ft., and in. to ft.
 WELL WATER TO BE USED AS: 5 Public water supply 8 Air conditioning 11 Injection well
 1 Domestic 3 Feedlot 6 Oil field water supply 9 Dewatering 12 Other (Specify below)
 2 Irrigation 4 Industrial 7 Lawn and garden only 10 Observation well
 Was a chemical/bacteriological sample submitted to Department? Yes.....No*.....; If yes, mo/day/yr sample was submitted
 Water Well Disinfected? Yes * No

TYPE OF BLANK CASING USED: 5 Wrought iron 8 Concrete tile CASING JOINTS: Glued * Clamped
 1 Steel 3 RMP (SR) 6 Asbestos-Cement 9 Other (specify below) Welded
 2 PVC 4 ABS 7 Fiberglass Threaded
 Blank casing diameter .. 5 in. to 97 ft., Dia in. to ft., Dia in. to ft.
 Casing height above land surface .. 14 in., weight .. 160 lbs./ft. Wall thickness or gauge No. 214

TYPE OF SCREEN OR PERFORATION MATERIAL: 7 PVC 10 Asbestos-cement
 1 Steel 3 Stainless steel 5 Fiberglass 8 RMP (SR) 11 Other (specify)
 2 Brass 4 Galvanized steel 6 Concrete tile 9 ABS 12 None used (open hole)

SCREEN OR PERFORATION OPENINGS ARE: 5 Gauzed wrapped 8 Saw cut 11 None (open hole)
 1 Continuous slot 3 Mill slot 6 Wire wrapped 9 Drilled holes
 2 Louvered shutter 4 Key punched 7 Torch cut 10 Other (specify)

SCREEN-PERFORATED INTERVALS: From 67 ft. to 97 ft., From ft. to ft.
 From ft. to ft., From ft. to ft.
 GRAVEL PACK INTERVALS: From 25 ft. to 97 ft., From ft. to ft.
 From ft. to ft., From ft. to ft.

GROUT MATERIAL: 1 Neat cement 2 Cement grout 3 Bentonite 4 Other
 Grout Intervals: From 4 ft. to 25 ft., From ft. to ft., From ft. to ft.
 What is the nearest source of possible contamination:
 1 Septic tank 4 Lateral lines 7 Pit privy 10 Livestock pens 14 Abandoned water well
 2 Sewer lines 5 Cess pool 8 Sewage lagoon 11 Fuel storage 15 Oil well/Gas well
 3 Watertight sewer lines 6 Seepage pit 9 Feedyard 12 Fertilizer storage 16 Other (specify below)
 13 Insecticide storage
 Direction from well? SOUTHWEST How many feet? 175

FROM	TO	LITHOLOGIC LOG	FROM	TO	LITHOLOGIC LOG
0	3	Brown clay			
3	10	RED CLAY			
10	28	LITE COLOR CLAY & SHALE			
28	38	LIMESTONE			
38	44	GRAY CLAY & SHALE			
44	54	LITE COLOR SHALE			
54	67	RED CLAY & SHALE			
67	73	lite color shale			
73	76	LIMESTONE			
76	78	LITE COLOR SHALE			
78	81	LIMESTONE			
81	84	LITE GRAY SHALE			
84	86	LIMESTONE			

CONTRACTOR'S OR LANDOWNER'S CERTIFICATION: This water well was (1) constructed, (2) reconstructed, or (3) plugged under my jurisdiction and was completed on (mo/day/year) 6 / 7 / 88 and this record is true to the best of my knowledge and belief. Kansas Water Well Contractor's License No. 397 This Water Well Record was completed on (mo/day/yr) 6 / 24 / 88 under the business name of CENTRAL KANSAS DRILLING by (signature) Harold D. Martin