


LOCATION OF WATER WELL: County: <u>Dickinson</u>	Fraction <u>SE</u> 1/4 <u>NE</u> 1/4 <u>NE</u> 1/4	Section Number <u>9</u>	Township Number T <u>13</u> S	Range Number R <u>2</u> <u>E</u>
-----------------------------------------------------	-------------------------------------------------------	----------------------------	----------------------------------	-------------------------------------

Distance and direction from nearest town or city street address of well if located within city?
1/2 mile East on Hwy 40 - 15 Jet 3/4 North & 1/4 West at Abilene, Kansas

WATER WELL OWNER Don Bartley
 RR#, St. Address, Box # Rt 1
 City, State, ZIP Code Abilene, Kansas: 67410
 Board of Agriculture, Division of Water Resources
 Application Number:

LOCATE WELL'S LOCATION WITH AN "X" IN SECTION BOX:

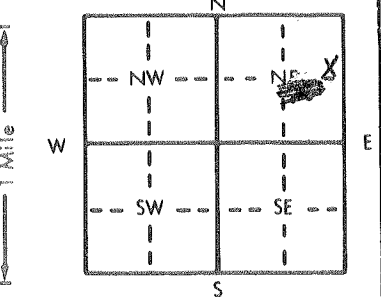

DEPTH OF COMPLETED WELL... 91 ft. ELEVATION:

Depth(s) Groundwater Encountered 1. 56 ft. 2. ft. 3. ft.

WELL'S STATIC WATER LEVEL ... 53 ft. below land surface measured on mo/day/yr 6 / 2 / 88

Pump test data: Well water was ft. after hours pumping gpm

Est. Yield 10-12 gpm: Well water was ft. after hours pumping gpm

Bore Hole Diameter. . 9 in. to 91 ft., and in. to ft.

WELL WATER TO BE USED AS: 5 Public water supply 8 Air conditioning 11 Injection well
 1 Domestic 3 Feedlot 6 Oil field water supply 9 Dewatering 12 Other (Specify below)
 2 Irrigation 4 Industrial 7 Lawn and garden only 10 Observation well

Was a chemical/bacteriological sample submitted to Department? Yes.....No...*.....; If yes, mo/day/yr sample was submitted

Water Well Disinfected? Yes * No

TYPE OF BLANK CASING USED:

1 Steel	3 RMP (SR)	5 Wrought iron	8 Concrete tile	CASING JOINTS: Glued . * Clamped
2 PVC	4 ABS	6 Asbestos-Cement	9 Other (specify below)	Welded
		7 Fiberglass		Threaded.

Blank casing diameter 5 in. to 91 ft., Dia in. to ft., Dia in. to ft.

Casing height above land surface. 13 in., weight 160 lbs./ft. Wall thickness or gauge No. .214

TYPE OF SCREEN OR PERFORATION MATERIAL:

1 Steel	3 Stainless steel	5 Fiberglass	7 PVC	10 Asbestos-cement
2 Brass	4 Galvanized steel	6 Concrete tile	8 RMP (SR)	11 Other (specify)
			9 ABS	12 None used (open hole)

SCREEN OR PERFORATION OPENINGS ARE:

1 Continuous slot	3 Mill slot	5 Gauzed wrapped	8 Saw cut	11 None (open hole)
2 Louvered shutter	4 Key punched	6 Wire wrapped	9 Drilled holes	
		7 Torch cut	10 Other (specify)	

SCREEN-PERFORATED INTERVALS: From 51 ft. to 91 ft., From ft. to ft.

GRAVEL PACK INTERVALS: From 27 ft. to 91 ft., From ft. to ft.

GROUT MATERIAL: 1 Neat cement 2 Cement grout 3 Bentonite 4 Other

Grout Intervals: From 4 ft. to 27 ft., From ft. to ft., From ft. to ft.

What is the nearest source of possible contamination:

1 Septic tank	4 Lateral lines	7 Pit privy	10 Livestock pens	14 Abandoned water well
2 Sewer lines	5 Cess pool	8 Sewage lagoon	11 Fuel storage	15 Oil well/Gas well
3 Watertight sewer lines	6 Seepage pit	9 Feedyard	12 Fertilizer storage	16 Other (specify below)
			13 Insecticide storage	

Direction from well? NORTHEAST How many feet? 130

FROM	TO	LITHOLOGIC LOG	FROM	TO	LITHOLOGIC LOG
0	6	DARK TOP SOIL			
6	18	LITE COLOR CLAY & SHALE			
18	23	LIMESTONE			
23	34	GRAY CLAY & SHALE			
34	40	LITE COLOR SHALE			
40	55	RED SHALE			
55	57	LITE COLOR SHALE			
57	59	LIMESTONE			
59	68	LITE COLOR SHALE			
68	69	LIMESTONE			
69	80	LITE GRAY SHALE			
80	88	DARK GRAY SHALE			
88	91	B LACK SHALE			

CONTRACTOR'S OR LANDOWNER'S CERTIFICATION: This water well was (1) constructed, (2) reconstructed, or (3) plugged under my jurisdiction and was completed on (mo/day/year) . . . 6 / 2 / 88 and this record is true to the best of my knowledge and belief. Kansas Water Well Contractor's License No. 397 This Water Well Record was completed on (mo/day/yr) . 6 / 24 / 88 under the business name of CENTRAL KANSAS DRILLING by (signature) Arnold D. Martin

INSTRUCTIONS: Use typewriter or ball point pen. PLEASE PRESS FIRMLY and PRINT clearly. Please fill in blanks, underline or circle the correct answers. Send top three copies to Kansas Department of Health and Environment, Bureau of Water Protection, Topeka, Kansas 66620-7320, Telephone: 913-862-9360. Send one to WATER WELL OWNER and retain one for your records.