


1] LOCATION OF WATER WELL: County: <b>Dickinson</b>	Fraction <b>SE 1/4 SE 1/4 NW 1/4</b>	Section Number <b>9</b>	Township Number <b>T 13 S</b>	Range Number <b>R 2</b>
--	---	----------------------------	----------------------------------	----------------------------

Distance and direction from nearest town or city street address of well if located within city?

**2002 North Buckeye, Abilene, Kansas**

2] WATER WELL OWNER: RR#, St. Address, Box # : City, State, ZIP Code :	<b>Amoco Oil Company</b> <b>8700 Indian Creek Parkway, Suite 100</b> <b>Overland Park, Kansas 66210</b>	Board of Agriculture, Division of Water Resources Application Number:
--	---	--

3] LOCATE WELL'S LOCATION WITH AN "X" IN SECTION BOX:

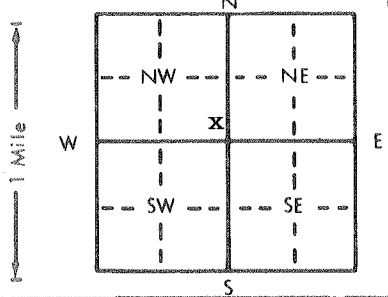

4] DEPTH OF COMPLETED WELL: <b>28.5</b> ft. ELEVATION:
Depth(s) Groundwater Encountered 1. <b>Dry</b> ft. 2. ft. 3. ft.
WELL'S STATIC WATER LEVEL <b>Dry</b> ft. below land surface measured on mo/day/yr <b>10/24/89</b>
Pump test data: Well water was ft. after hours pumping gpm
Est. Yield gpm: Well water was ft. after hours pumping gpm
Bore Hole Diameter <b>6</b> in. to <b>28.5</b> ft., and in. to ft.
WELL WATER TO BE USED AS:
5 Public water supply 8 Air conditioning 11 Injection well
1 Domestic 3 Feedlot 6 Oil field water supply 9 Dewatering 12 Other (Specify below)
2 Irrigation 4 Industrial 7 Lawn and garden only 10 <u>Monitoring well</u>
Was a chemical/bacteriological sample submitted to Department? Yes.....No... <b>X</b> .....; If yes, mo/day/yr sample was submitted
Water Well Disinfected? Yes No <b>X</b>

5] TYPE OF BLANK CASING USED:	5 Wrought iron	8 Concrete tile	CASING JOINTS: Glued Clamped
1 Steel	3 RMP (SR)	6 Asbestos-Cement	9 Other (specify below)
2 PVC	4 ABS	7 Fiberglass	10 Asbestos-cement
Blank casing diameter <b>2</b> in. to <b>8.55</b> ft., Dia. in. to ft., Dia. in. to ft.			11 Other (specify)
Casing height above land surface <b>-0.36</b> in., weight lbs./ft. Wall thickness or gauge No. <b>SCH 40</b>			12 None used (open hole)
TYPE OF SCREEN OR PERFORATION MATERIAL:	7 <u>PVC</u>		
1 Steel	3 Stainless steel	5 Fiberglass	8 RMP (SR)
2 Brass	4 Galvanized steel	6 Concrete tile	9 ABS
SCREEN OR PERFORATION OPENINGS ARE:	5 Gauzed wrapped	8 Saw cut	11 None (open hole)
1 Continuous slot	3 <u>Mill slot</u>	6 Wire wrapped	9 Drilled holes
2 Louvered shutter	4 Key punched	7 Torch cut	10 Other (specify)
SCREEN-PERFORATED INTERVALS: From <b>8.55</b> ft. to <b>27.55</b> ft., From ft. to ft.			
GRAVEL PACK INTERVALS: From <b>7.5</b> ft. to <b>28.5</b> ft., From ft. to ft.			

6] GROUT MATERIAL:	1 Neat cement	2 <u>Cement grout</u>	3 <u>Bentonite</u>	4 Other
Grout Intervals: From <b>0.0</b> ft. to <b>5.5</b> ft., From <b>5.5</b> ft. to <b>7.5</b> ft., From ft. to ft.				
What is the nearest source of possible contamination:				
1 Septic tank	4 Lateral lines	7 Pit privy	10 Livestock pens	14 Abandoned water well
2 Sewer lines	5 Cess pool	8 Sewage lagoon	11 <u>Fuel storage</u>	15 Oil well/Gas well
3 Watertight sewer lines	6 Seepage pit	9 Feedyard	12 Fertilizer storage	16 Other (specify below)
Direction from well? <b>North</b>			13 Insecticide storage	
			How many feet? <b>6.0'</b>	

FROM	TO	LITHOLOGIC LOG	FROM	TO	PLUGGING INTERVALS
0.0	0.5	Concrete			
0.5	2.0	Lean to Fat Clay, Dark Gray, Moist			
2.0	5.5	Lean to Fat Clay, Red Brown, Moist Stiff			
5.5	15.0	Silt with Sand Light Brown, Moist			
15.0	23.0	Sand, Anuglar to Subangular Medium to Fine, Well Graded			
23.0	28.5	Lean to Fat Clay, Light Gray, Moist			

7] CONTRACTOR'S OR LANDOWNER'S CERTIFICATION: This water well was (1) <u>constructed</u> , (2) reconstructed, or (3) plugged under my jurisdiction and was completed on (mo/day/year) <b>10/10/89</b> and this record is true to the best of my knowledge and belief. Kansas Water Well Contractor's License No. <b>416</b> This Water Well Record was completed on (mo/day/yr) <b>11/01/89</b> under the business name of <b>Terracon Consultants</b> by (signature) <i>D. Semley</i>
--

INSTRUCTIONS: Use typewriter or ball point pen. PLEASE PRESS FIRMLY and PRINT clearly. Please fill in blanks, underline or circle the correct answers. Send top three copies to Kansas Department of Health and Environment, Bureau of Water Protection, Topeka, Kansas 66620-7320. Telephone: 913-296-5514. Send one to WATER WELL OWNER and retain one for your records.