

1 LOCATION OF WATER WELL: County: Dickinson	Fraction SE 1/4 SE 1/4 NW 1/4	Section Number 9	Township Number T 13 S	Range Number R 2
---	---	----------------------------	----------------------------------	----------------------------


Distance and direction from nearest town or city street address of well if located within city?

2002 North Buckeye, Abilene, Kansas

2 WATER WELL OWNER: **Amoco Oil Company**
 RR#, St. Address, Box #: **8700 Indian Creek Parkway, Suite 100**
 City, State, ZIP Code: **Overland Park, Kansas 66210**

Board of Agriculture, Division of Water Resources
 Application Number:

3 LOCATE WELL'S LOCATION WITH AN "X" IN SECTION BOX:

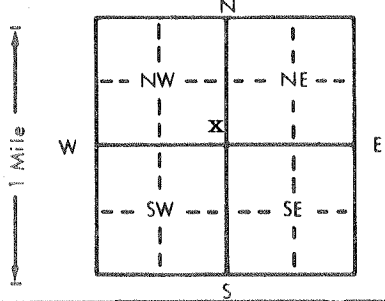

4 DEPTH OF COMPLETED WELL: **28.0** ft. ELEVATION: _____ ft.

Depth(s) Groundwater Encountered 1. **Dry** ft. 2. _____ ft. 3. _____ ft.

WELL'S STATIC WATER LEVEL: **Dry** ft. below land surface measured on mo/day/yr **10/24/89**

Pump test data: Well water was _____ ft. after _____ hours pumping _____ gpm

Est. Yield _____ gpm: Well water was _____ ft. after _____ hours pumping _____ gpm

Bore Hole Diameter: **6** in. to **28.0** ft., and _____ in. to _____ ft.

WELL WATER TO BE USED AS:

5 Public water supply	8 Air conditioning	11 Injection well
1 Domestic	3 Feedlot	6 Oil field water supply
2 Irrigation	4 Industrial	7 Lawn and garden only
		10 Monitoring well

12 Other (Specify below) _____

Was a chemical/bacteriological sample submitted to Department? Yes _____ No **X**; If yes, mo/day/yr sample was submitted _____

Water Well Disinfected? Yes _____ No **X**

5 TYPE OF BLANK CASING USED:

1 Steel	3 RMP (SR)	5 Wrought iron	8 Concrete tile	CASING JOINTS: Glued _____ Clamped _____
2 PVC	4 ABS	6 Asbestos-Cement	9 Other (specify below) _____	Welded _____
		7 Fiberglass		Threaded X

Blank casing diameter: **2** in. to **8.05'** ft., Dia _____ in. to _____ ft., Dia _____ in. to _____ ft.

Casing height above land surface: **-0.35'** in., weight _____ lbs./ft. Wall thickness or gauge No. **SCH 40**

TYPE OF SCREEN OR PERFORATION MATERIAL:

1 Steel	3 Stainless steel	5 Fiberglass	8 RMP (SR)	10 Asbestos-cement
2 Brass	4 Galvanized steel	6 Concrete tile	9 ABS	11 Other (specify) _____
				12 None used (open hole)

SCREEN OR PERFORATION OPENINGS ARE:

1 Continuous slot	3 Mill slot	5 Gauzed wrapped	8 Saw cut	11 None (open hole)
2 Louvered shutter	4 Key punched	6 Wire wrapped	9 Drilled holes	
		7 Torch cut	10 Other (specify) _____	

SCREEN-PERFORATED INTERVALS: From **8.05** ft. to **27.05** ft., From _____ ft. to _____ ft.

GRAVEL PACK INTERVALS: From **7.0** ft. to **28.0** ft., From _____ ft. to _____ ft.

6 GROUT MATERIAL:

1 Neat cement	2 Cement grout	3 Bentonite	4 Other _____
---------------	----------------	-------------	---------------

GROUT INTERVALS: From **0.0** ft. to **5.0** ft., From **5.0** ft. to **5.0** ft., From **7.0** ft. to _____ ft.

What is the nearest source of possible contamination:

1 Septic tank	4 Lateral lines	7 Pit privy	10 Livestock pens	14 Abandoned water well
2 Sewer lines	5 Cess pool	8 Sewage lagoon	11 Fuel storage	15 Oil well/Gas well
3 Watertight sewer lines	6 Seepage pit	9 Feedyard	12 Fertilizer storage	16 Other (specify below) _____
			13 Insecticide storage	

Direction from well? **East** How many feet? **5'**

FROM	TO	LITHOLOGIC LOG	FROM	TO	PLUGGING INTERVALS
0.0	0.5	Asphalt	18.0	23.0	Sand Angular to Subangular Medium to Fine, Well Graded
0.5	1.75	Lean to Fat Clay, Dark Gray, Moist			
1.75	2.5	Lean to Fat Clay, Mottled Gray and Reddish Brown, Moist, Stiff	23.0	28.0	Lean to Fat Clay, Light Gray Moist
2.5	5.5	Lean to Fat Clay, Reddish Brown, Moist, Stiff			
5.5	16.0	Silt, Light Brown, Moist			
16.0	18.0	Silty Sand, Angular to Subangular Fine to Medium Well Graded			

7 CONTRACTOR'S OR LANDOWNER'S CERTIFICATION: This water well was (1) constructed, (2) reconstructed, or (3) plugged under my jurisdiction and was completed on (mo/day/year) **10/10/89** and this record is true to the best of my knowledge and belief. Kansas Water Well Contractor's License No. **416** This Water Well Record was completed on (mo/day/yr) **11/01/89** under the business name of **Terracon Consultants** by (signature) *W. J. Genley*