


1 LOCATION OF WATER WELL: County: **DICKINSON** Fraction: **NE SE SW** Section Number: **16** Township Number: **T 22 13 S** Range Number: **R X 2 EW**

Distance and direction from nearest town or city street address of well if located within city?
400 N BUCKEYE - ABILENE

2 WATER WELL OWNER: **M. ZOOK**
RR#, St. Address, Box #: **400 N BUCKEYE**
City, State, ZIP Code: **ABILENE KS. 67410**
Board of Agriculture, Division of Water Resources
Application Number:

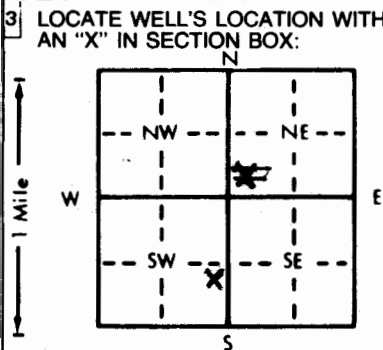

4 DEPTH OF COMPLETED WELL: **25** ft. ELEVATION: _____
Depth(s) Groundwater Encountered 1. **14** ft. 2. _____ ft. 3. _____ ft.
WELL'S STATIC WATER LEVEL: **10.45** ft. below land surface measured on mo/day/yr **01-28-94**
Pump test data: Well water was _____ ft. after _____ hours pumping _____ gpm
Est. Yield _____ gpm: Well water was _____ ft. after _____ hours pumping _____ gpm
Bore Hole Diameter: **7.25** in. to **25** ft., and _____ in. to _____ ft.
WELL WATER TO BE USED AS:
5 Public water supply 8 Air conditioning 11 Injection well
1 Domestic 3 Feedlot 6 Oil field water supply 9 Dewatering 12 Other (Specify below)
2 Irrigation 4 Industrial 7 Lawn and garden only 10 Monitoring well
Was a chemical/bacteriological sample submitted to Department? Yes _____ No **X**; If yes, mo/day/yr sample was submitted _____
Water Well Disinfected? Yes _____ No **X**

5 TYPE OF BLANK CASING USED:
1 Steel 3 RMP (SR) 5 Wrought iron 8 Concrete tile CASING JOINTS: Glued _____ Clamped _____
2 PVC 4 ABS 6 Asbestos-Cement 9 Other (specify below) Welded _____
7 Fiberglass Threaded **X**
Blank casing diameter: **2** in. to **11** ft., Dia _____ in. to _____ ft., Dia _____ in. to _____ ft.
Casing height above land surface: **FLUSH** in., weight: **SCH 40** lbs./ft. Wall thickness or gauge No. _____
TYPE OF SCREEN OR PERFORATION MATERIAL:
1 Steel 3 Stainless steel 5 Fiberglass 7 PVC 10 Asbestos-cement
2 Brass 4 Galvanized steel 6 Concrete tile 8 RMP (SR) 11 Other (specify) _____
9 ABS 12 None used (open hole)
SCREEN OR PERFORATION OPENINGS ARE:
1 Continuous slot 3 Mill slot 5 Gauzed wrapped 8 Saw cut 11 None (open hole)
2 Louvered shutter 4 Key punched 6 Wire wrapped 9 Drilled holes
7 Torch cut 10 Other (specify) _____
SCREEN-PERFORATED INTERVALS: From **11** ft. to **21** ft., From _____ ft. to _____ ft.
From _____ ft. to _____ ft., From _____ ft. to _____ ft.
~~GRAVEL~~ PACK INTERVALS: From **10** ft. to **25** ft., From _____ ft. to _____ ft.
From _____ ft. to _____ ft., From _____ ft. to _____ ft.

6 GROUT MATERIAL: 1 Neat cement 2 Cement grout 3 Bentonite 4 Other _____
Grout Intervals: From **5L** ft. to **7** ft., From **3 7** ft. to **10** ft., From _____ ft. to _____ ft.
What is the nearest source of possible contamination:
1 Septic tank 4 Lateral lines 7 Pit privy 10 Livestock pens 14 Abandoned water well
2 Sewer lines 5 Cess pool 8 Sewage lagoon 11 Fuel storage 15 Oil well/Gas well
3 Watertight sewer lines 6 Seepage pit 9 Feedyard 12 Fertilizer storage 16 Other (specify below)
13 Insecticide storage **CONTAMINATED SITE**
Direction from well? _____ How many feet? _____

FROM	TO	LITHOLOGIC LOG	FROM	TO	PLUGGING INTERVALS
5L	1	CONCRETE			
1	4	CLAY SILT			
4	19	SILTY CLAY			
19	21	SANDY CLAY - WITH SAND STRINGERS			
21	25	CLAY			
25	25				

7 CONTRACTOR'S OR LANDOWNER'S CERTIFICATION: This water well was (1) constructed, (2) reconstructed, or (3) plugged under my jurisdiction and was completed on (mo/day/year) **01-25-94** and this record is true to the best of my knowledge and belief. Kansas Water Well Contractor's License No. **479** This Water Well Record was completed on (mo/day/yr) **02-18-94** under the business name of **EBBERTS DRILLING** by (signature) *Arayan Ebbert*

OFFICE USE ONLY

T

R

EW

SEC

1/4

1/4

1/4