


MU-1

1 LOCATION OF WATER WELL: County: DICKINSON Fraction: SW 1/4 SW 1/4 NE 1/4 S1/2 Section Number: 16 Township Number: T 22 13 S Range Number: R X 2 E

Distance and direction from nearest town or city street address of well if located within city?
400 N BUCKEYE - ABILENE

2 WATER WELL OWNER: M. ZUBIK BUDS TRRE
RR#, St. Address, Box #: 400 N BUCKEYE
City, State, ZIP Code: ABILENE KS 67410
Board of Agriculture, Division of Water Resources
Application Number: _____

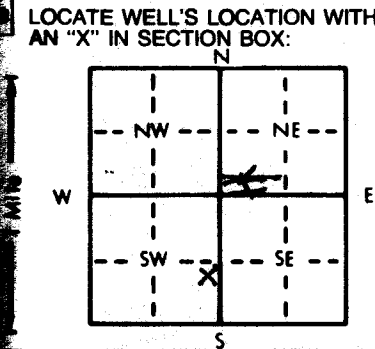

4 DEPTH OF COMPLETED WELL: 22 ft. ELEVATION: _____
Depth(s) Groundwater Encountered 1. 14 ft. 2. _____ ft. 3. _____ ft.
WELL'S STATIC WATER LEVEL: 9.65 ft. below land surface measured on mo/day/yr 01-28-74
Pump test data: Well water was _____ ft. after _____ hours pumping _____ gpm
Est. Yield _____ gpm Well water was _____ ft. after _____ hours pumping _____ gpm
Bore Hole Diameter: 2.25 in. to 22 ft., and _____ in. to _____ ft.
WELL WATER TO BE USED AS:
5 Public water supply 8 Air conditioning 11 Injection well
1 Domestic 3 Feedlot 6 Oil field water supply 9 Dewatering 12 Other (Specify below)
2 Irrigation 4 Industrial 7 Lawn and garden only 10 Monitoring well
Was a chemical/bacteriological sample submitted to Department? Yes _____ No X; If yes, mo/day/yr sample was submitted _____
Water Well Disinfected? Yes _____ No X

TYPE OF BLANK CASING USED:
1 Steel 3 RMP (SR) 5 Wrought iron 8 Concrete tile CASING JOINTS: Glued _____ Clamped _____
2 PVC 4 ABS 6 Asbestos-Cement 9 Other (specify below) Welded _____
7 Fiberglass _____ Threaded X

Blank casing diameter: 2 in. to 9.3 ft., Dia _____ in. to _____ ft., Dia _____ in. to _____ ft.
Casing height above land surface: FLUSH in., weight SCH 40 lbs./ft. Wall thickness or gauge No. _____

TYPE OF SCREEN OR PERFORATION MATERIAL:
1 Steel 3 Stainless steel 5 Fiberglass 7 PVC 10 Asbestos-cement
2 Brass 4 Galvanized steel 6 Concrete tile 8 RMP (SR) 11 Other (specify) _____
9 ABS 12 None used (open hole)

SCREEN OR PERFORATION OPENINGS ARE:
1 Continuous slot 3 Mill slot 5 Gauzed wrapped 8 Saw cut 11 None (open hole)
2 Louvered shutter 4 Key punched 6 Wire wrapped 9 Drilled holes
7 Torch cut 10 Other (specify) _____

SCREEN-PERFORATED INTERVALS: From 9.3 ft. to 19.3 ft., From _____ ft. to _____ ft.
From _____ ft. to _____ ft., From _____ ft. to _____ ft.
~~GRAVEL~~ PACK INTERVALS: From 8.9 ft. to 22 ft., From _____ ft. to _____ ft.
From _____ ft. to _____ ft., From _____ ft. to _____ ft.

5 GROUT MATERIAL: 1 Neat cement 2 Cement grout 3 Bentonite 4 Other _____
Grout Intervals: From GL ft. to 6 ft., From 5 ft. to 8.9 ft., From _____ ft. to _____ ft.

What is the nearest source of possible contamination:
1 Septic tank 4 Lateral lines 7 Pit privy 10 Livestock pens 14 Abandoned water well
2 Sewer lines 5 Cess pool 8 Sewage lagoon 11 Fuel storage 15 Oil well/Gas well
3 Watertight sewer lines 6 Seepage pit 9 Feedyard 12 Fertilizer storage 16 Other (specify below)
13 Insecticide storage CONTAMINATED SITE

Direction from well? _____ How many feet? _____

| FROM | TO | LITHOLOGIC LOG | FROM | TO | PLUGGING INTERVALS |
|-----------|-----------|-------------------------------|------|----|--------------------|
| <u>GL</u> | <u>1</u> | <u>CONCRETE AND SAND FILL</u> | | | |
| <u>1</u> | <u>5</u> | <u>CLAY SILT</u> | | | |
| <u>5</u> | <u>13</u> | <u>SILTY CLAY</u> | | | |
| <u>13</u> | <u>14</u> | <u>SANDY CLAY</u> | | | |
| <u>14</u> | <u>16</u> | <u>SILTY SAND</u> | | | |
| <u>16</u> | <u>18</u> | <u>CLAY SILT</u> | | | |
| <u>18</u> | <u>22</u> | <u>SILTY CLAY</u> | | | |
| <u>TD</u> | <u>22</u> | | | | |

7 CONTRACTOR'S OR LANDOWNER'S CERTIFICATION: This water well was (1) constructed, (2) reconstructed, or (3) plugged under my jurisdiction and was completed on (mo/day/year) 01-24-74 and this record is true to the best of my knowledge and belief. Kansas Water Well Contractor's License No. 479 This Water Well Record was completed on (mo/day/yr) 02-18-74 under the business name of EBBERTS DRILLING by (signature) Arogan Ebberts