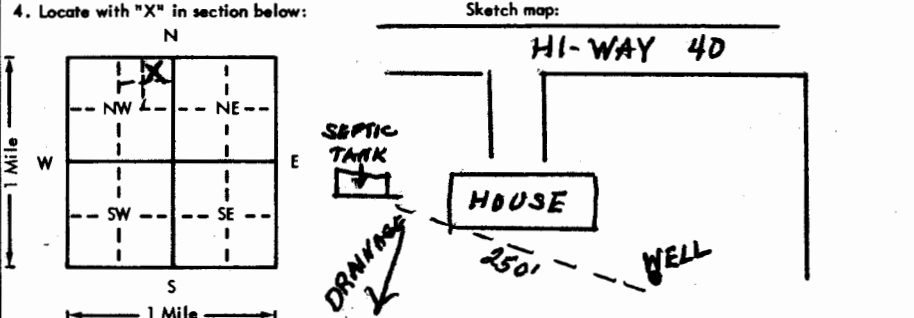


USE TYPEWRITER OR BALL POINT PEN-PRESS FIRMLY, PRINT CLEARLY.

WATER WELL RECORD
KSA 82a-1201-1215

Kansas Department of Health and Environment-Division of Environment
(Water well Contractors)
Topeka, Kansas 66620

1. Location of well:		County Dickinson	Fraction NE 1/4 NE 1/4 NW 1/4	Section number 17	Township number T 13 S R 2	Range number (E/W)
2. Distance and direction from nearest town or city: Street address of well location if in city: 1 mile west of Abilene				3. Owner of well: Claret Farms, Inc. R.R. or street: Box 511 City, state, zip code: Abilene, Kansas 67410		
4. Locate with "X" in section below: Sketch map: 				6. Bore hole dia. 8 in. Completion date 5/21/86 Well depth 61 ft.		
5. Type and color of material				7. <input checked="" type="checkbox"/> Cable tool Rotary <input type="checkbox"/> Driven <input type="checkbox"/> Aug <input type="checkbox"/> Hollow rod <input type="checkbox"/> Jetted <input type="checkbox"/> Bored <input type="checkbox"/> Reverse rotary		
				8. Use: <input checked="" type="checkbox"/> Domestic <input type="checkbox"/> Public supply <input type="checkbox"/> Industry <input type="checkbox"/> Irrigation <input type="checkbox"/> Air conditioning <input type="checkbox"/> Stock <input type="checkbox"/> Lawn <input type="checkbox"/> Oil field water <input type="checkbox"/> Other		
				9. Casing: Material Plst Height: Above or below Threaded <input type="checkbox"/> Welded gl Surface 18 in. RAMP <input checked="" type="checkbox"/> PVC Weight _____ lbs./ft. Dia. 5 in. to 61 ft. depth; Wall Thickness: inches or Dia. _____ in. to _____ ft. depth; gage No. 0.258		
				10. Screen: Manufacturer's name Western Plastics Type RMP Dia. 5" Slot/gauze 3/32 Length 12 Set between 49 ft. and 61 ft. _____ ft. and _____ ft. Gravel pack? <input checked="" type="checkbox"/> Size range of material 1/16 to 3/8		
				11. Static water level: _____ mo./day/yr. 36 ft. below land surface Date 5/21/76		
				12. Pumping level below land surfaces: _____ ft. after _____ hrs. pumping _____ g.p.m. _____ ft. after _____ hrs. pumping _____ g.p.m. Estimated maximum yield 16+ g.p.m.		
				13. Water sample submitted: _____ mo./day/yr. Yes <input checked="" type="checkbox"/> No <input type="checkbox"/> Date _____		
				14. Well head completion: <input type="checkbox"/> Pitless adapter 18 inches above grade		
				15. Well grouted? Yes With: <input type="checkbox"/> Neat cement <input type="checkbox"/> Bentonite <input checked="" type="checkbox"/> Concrete Depth: From 0 ft. to 10 ft.		
				16. Nearest source of possible contamination: septic ft. 250 Direction N.W. Type tank Well disinfected upon completion? <input type="checkbox"/> Yes <input type="checkbox"/> No		
				17. Pump: <input checked="" type="checkbox"/> Not installed Manufacturer's name _____ Model number _____ HP _____ Volts _____ Length of drop pipe _____ ft. capacity _____ g.p.m. Type: <input type="checkbox"/> Submersible <input type="checkbox"/> Turbine <input type="checkbox"/> Jet <input type="checkbox"/> Reciprocating <input type="checkbox"/> Centrifugal <input type="checkbox"/> Other		
18. Elevation:				19. Remarks: Concrete slab to be installed by customer at surface of ground.		
Topography: <input type="checkbox"/> Hill <input type="checkbox"/> Slope <input type="checkbox"/> Upland <input checked="" type="checkbox"/> Valley				20. Water well contractor's certification: This well was drilled under my jurisdiction and this report is true to the best of my knowledge and belief. Rader Drilling Co. 194 Business name Address Carlton, Kansas 67429 License No. _____ Signed Boyd E. Rader Date 6-2-86 Authorized representative		

T 13 S R 2 E/W
 Sec 17
 1/4 1/4 1/4 1/4
 NE NE NW NW

Forward the white, blue and pink copies to the Department of Health and Environment

Form WWC-5