

1 LOCATION OF WATER WELL: Fraction SW 1/4 NW 1/4 NW 1/4 Section Number 18 Township Number T 13 S Range Number R 2 E


Distance and direction from nearest town or city street address of well if located within city?

1 1/2 miles West of Abilene

2 WATER WELL OWNER: Fast Pace Kennels  
 RR#, St. Address, Box #: Rt 4  
 City, State, ZIP Code: Abilene, KS 67410

Board of Agriculture, Division of Water Resources  
 Application Number:

3 LOCATE WELL'S LOCATION WITH AN "X" IN SECTION BOX:

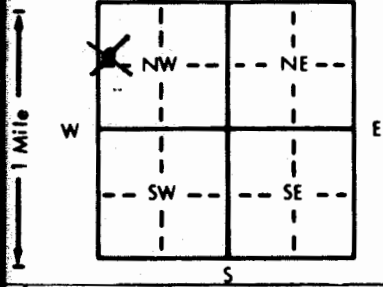

4 DEPTH OF COMPLETED WELL: 60 ft. ELEVATION:

Depth(s) Groundwater Encountered 1. 15 ft. 2. ft. 3. ft.  
 WELL'S STATIC WATER LEVEL . . . 15 ft. below land surface measured on mo/day/yr 2-12 & 14-94  
 Pump test data: Well water was . . . ft. after . . . hours pumping . . . gpm  
 Est. Yield .100 gpm: Well water was . . . ft. after . . . hours pumping . . . gpm  
 Bore Hole Diameter . . . 8 in. to . . . 60 ft., and . . . in. to . . . ft.  
 WELL WATER TO BE USED AS:  
 1 Domestic 3 Feedlot 6 Oil field water supply 9 Dewatering 12 Other (Specify below)  
 2 Irrigation 4 Industrial 7 Lawn and garden only 10 Monitoring well  
 Was a chemical/bacteriological sample submitted to Department? Yes . . . No . . . X . . . ; If yes, mo/day/yr sample was submitted  
 Water Well Disinfected? Yes X No

5 TYPE OF BLANK CASING USED:  
 1 Steel 3 RMP (SR) 5 Wrought iron 8 Concrete tile CASING JOINTS: Glued X Clamped  
 2 PVC 4 ABS 6 Asbestos-Cement 9 Other (specify below) Welded  
 7 Fiberglass Threaded

Blank casing diameter . . . 5 in. to . . . 5.1 ft., Dia . . . in. to . . . ft., Dia . . . in. to . . . ft.  
 Casing height above land surface . . . 12 in., weight . . . 2.37 lbs./ft. Wall thickness or gauge No. . . . 2.14

TYPE OF SCREEN OR PERFORATION MATERIAL: None-Open Hole 7 PVC 10 Asbestos-cement  
 1 Steel 3 Stainless steel 5 Fiberglass 51-60 8 RMP (SR) 11 Other (specify)  
 2 Brass 4 Galvanized steel 6 Concrete tile 9 ABS 12 None used (open hole)

SCREEN OR PERFORATION OPENINGS ARE:  
 1 Continuous slot 3 Mill slot 5 Gauzed wrapped 8 Saw cut 11 None (open hole)  
 2 Louvered shutter 4 Key punched 6 Wire wrapped 9 Drilled holes  
 7 Torch cut 10 Other (specify)

SCREEN-PERFORATED INTERVALS: From . . . ft. to . . . ft., From . . . ft. to . . . ft.  
 From . . . ft. to . . . ft., From . . . ft. to . . . ft.  
 GRAVEL PACK INTERVALS: From . . . 20 ft. to . . . 40 ft., From . . . ft. to . . . ft.  
 From 50 ft. to 51 ft., From . . . ft. to . . . ft.

6 GROUT MATERIAL: 1 Neat cement 2 Cement grout 3 Bentonite 4 Other

Grout intervals: From . . . 4 ft. to . . . 20 ft., From . . . 40 ft. to . . . 50 ft., From . . . ft. to . . . ft.

What is the nearest source of possible contamination:  
 1 Septic tank 4 Lateral lines 7 Pit privy 10 Livestock pens 14 Abandoned water well  
 2 Sewer lines 5 Cess pool 8 Sewage lagoon 11 Fuel storage 15 Oil well/Gas well  
 3 Watertight sewer lines 6 Seepage pit 9 Feedyard 12 Fertilizer storage 16 Other (specify below)  
 13 Insecticide storage

Direction from well? South How many feet? 100ft

FROM	TO	LITHOLOGIC LOG	FROM	TO	PLUGGING INTERVALS
0	3	Top Soil			
3	17	Sandy Red Clay			
17	26	Fine Sand			
26	35	Fine to Medium Sand			
35	50	Green & Gray Shale			
		Cased 51 ft			
50	55	Gray Shale			
55	56	Limestone			
56	57	Fractured Shale Cavity			
57	80	Gray Shale			

7 CONTRACTOR'S OR LANDOWNER'S CERTIFICATION: This water well was (1) constructed, (2) reconstructed, or (3) plugged under my jurisdiction and was completed on (mo/day/year) . . . 2-14-94 . . . and this record is true to the best of my knowledge and belief. Kansas Water Well Contractor's License No. . . . 138 . . . This Water Well Record was completed on (mo/day/yr) . . . 2-16-94 . . . under the business name of Peterson Irrigation Inc. by (signature)