USE TYPEWRITER OR BALL POINT PEN-PRESS FIRMLY, PRINT CLEARLY.

WATER WELL RECORD
KSA 82a-1201-1215

Kansas Department of Health and Environment-Division of Environment
(Water well Contractors)
Topeka, Kansas 66620

1. Location of well:	County	Fraction	Section number	Township number	Range number
	Dickinson	SE 1/4 NE 1/4 NW 1/4	21	T 13 S	R 2 (E)/W

2. Distance and direction from nearest town or city: 501 S.W. Fourth
Street address of well location if in city: Abilene, Kansas 67410

3. Owner of well: Herbert Rector
R.R. or street: 501 S.W. 4th
City, state, zip code: Abilene, Kansas

4. Locate with "X" in section below:

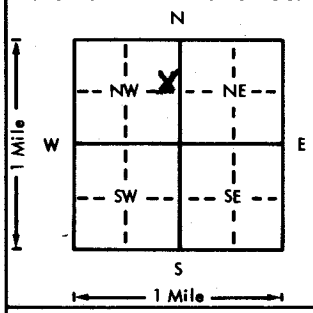

Sketch map:

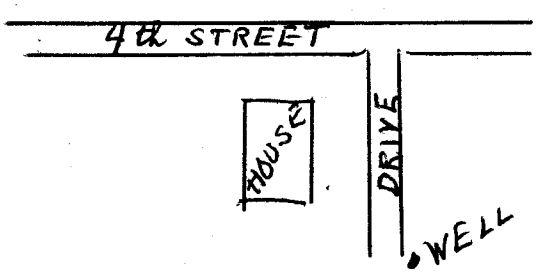

6. Bore hole dia. 8 in. Completion date 7-16-76
Well depth 55 ft.

7. __ Cable tool X Rotary __ Driven __ Dug
__ Hollow rod __ Jetted __ Bored __ Reverse rotary

8. Use: __ Domestic __ Public supply __ Industry
X Irrigation __ Air conditioning __ Stock
__ Lawn __ Oil field water __ Other

9. Casing: Material plst Height: Above or below
Threaded ___ Welded gl Surface 18 in.
RMP X PVC ___ Weight ___ lbs./ft.
Dia. 5 in. to 55 ft. depth Wall Thickness: inches or
Dia. ___ in. to ___ ft. depth gage No. 0.258

10. Screen: Manufacturer's name Western Plastics
Type RMP Dia. 5"
Slot/gauze 3/32 Length 5'
Set between 50 ft. and 55 ft.
___ ft. and ___ ft.
Gravel pack? Yes Size range of material 1/16 to 3/8

11. Static water level: mo./day/yr.
28 ft. below land surface Date 7/16/76

12. Pumping level below land surfaces:
___ ft. after ___ hrs. pumping ___ g.p.m.
___ ft. after ___ hrs. pumping ___ g.p.m.
Estimated maximum yield 25+ g.p.m.

13. Water sample submitted: mo./day/yr.
___ Yes X No Date ___

14. Well head completion:
___ Pitless adapter 18 Inches above grade

15. Well grouted? ___
With: ___ Neat cement ___ Bentonite ___ Concrete
Depth: From ___ ft. to ___ ft.

16. Nearest source of possible contamination:
ft. ___ Direction ___ Type ___
Well disinfected upon completion? ___ Yes X No

17. Pump: X Not installed
Manufacturer's name ___
Model number ___ HP ___ Volts ___
Length of drop pipe ___ ft. capacity ___ g.p.m.
Type:
___ Submersible ___ Turbine
___ Jet ___ Reciprocating
___ Centrifugal ___ Other

5. Type and color of material	From	To
Clay	0	50
Clay & gravel	50	55

(Use a second sheet if needed)

18. Elevation:

Topography:
___ Hill
___ Slope
___ Upland
___ Valley

19. Remarks:
Customer will grout the well

20. Water well contractor's certification:
This well was drilled under my jurisdiction and this report is true to the best of my knowledge and belief.
Business name Rader Drilling Co. License No. 194
Address Carlton, Kansas 67429
Signed Brent E Rader Date 8-26
Authorized representative

T 13 R 2 (E)/W Sec 21 1/4 SE 1/4 NW 1/4

Forward the white, blue and pink copies to the Department of Health and Environment

Form WWC-5

MI-1023