


1 LOCATION OF WATER WELL: County: Dickinson	Fraction NW 1/4 NW 1/4 NE 1/4	Section Number 21	Township Number T 13 S	Range Number R 2 E/W
--	----------------------------------	----------------------	---------------------------	--------------------------------

Distance and direction from nearest town or city street address of well if located within city?
 102 S Buckeye, Abilene, Kansas MW 3

2 WATER WELL OWNER: Mr. Clyde Howard
 RR#, St. Address, Box #: 102 S Buckeye Board of Agriculture, Division of Water Resources
 City, State, ZIP Code: Abilene, Ks. 67410 Application Number:

3 LOCATE WELL'S LOCATION WITH AN "X" IN SECTION BOX:

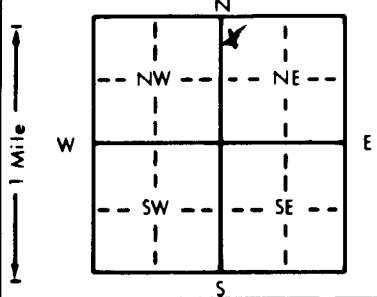

4 DEPTH OF COMPLETED WELL... 35 ft. ELEVATION:
 Depth(s) Groundwater Encountered 1. ft. 2. ft. 3. ft.
 WELL'S STATIC WATER LEVEL .27.93 ft. below land surface measured on mo/day/yr .8-26-91
 Pump test data: Well water was ft. after hours pumping gpm
 Est. Yield gpm: Well water was ft. after hours pumping gpm
 Bore Hole Diameter .7.5/8 in. to .35 ft., and in. to ft.
 WELL WATER TO BE USED AS: 5 Public water supply 8 Air conditioning 11 Injection well
 1 Domestic 3 Feedlot 6 Oil field water supply 9 Dewatering 12 Other (Specify below)
 2 Irrigation 4 Industrial 7 Lawn and garden only **10** Monitoring well
 Was a chemical/bacteriological sample submitted to Department? Yes.....No...**X**.....; If yes, mo/day/yr sample was submitted
 Water Well Disinfected? Yes No **X**

5 TYPE OF BLANK CASING USED:
 1 Steel 3 RMP (SR) 5 Wrought iron 8 Concrete tile CASING JOINTS: Glued Clamped
2 PVC 4 ABS 6 Asbestos-Cement 9 Other (specify below) Welded
 7 Fiberglass Threaded. **✓**
 Blank casing diameter2 in. to .20 ft., Dia in. to ft., Dia in. to ft.
 Casing height above land surface24 in., weight lbs./ft. Wall thickness or gauge No. **Schedule 40**
 TYPE OF SCREEN OR PERFORATION MATERIAL:
 1 Steel 3 Stainless steel 5 Fiberglass **7 PVC** 10 Asbestos-cement
 2 Brass 4 Galvanized steel 6 Concrete tile 9 ABS 11 Other (specify)
 12 None used (open hole)
 SCREEN OR PERFORATION OPENINGS ARE:
 1 Continuous slot **3 Mill slot** 5 Gauzed wrapped 8 Saw cut 11 None (open hole)
 2 Louvered shutter 4 Key punched 6 Wire wrapped 9 Drilled holes
 7 Torch cut 10 Other (specify)
 SCREEN-PERFORATED INTERVALS: From20 ft. to35 ft., From ft. to ft.
 From ft. to ft., From ft. to ft.
 GRAVEL PACK INTERVALS: From17.5 ft. to35 ft., From ft. to ft.
 From ft. to ft., From ft. to ft.

6 GROUT MATERIAL: 1 Neat cement **2 Cement grout** **3 Bentonite** 4 Other
 Grout Intervals: From ..0 ft. to 1(**cement**) ft., From ..1 ft. to ..17.5(**bent**) ft. From ft. to ft.
 What is the nearest source of possible contamination:
 1 Septic tank 4 Lateral lines 7 Pit privy **11 Fuel storage** 14 Abandoned water well
 2 Sewer lines 5 Cess pool 8 Sewage lagoon 12 Fertilizer storage 15 Oil well/Gas well
 3 Watertight sewer lines 6 Seepage pit 9 Feedyard 13 Insecticide storage 16 Other (specify below)
 Direction from well? **NW** How many feet? **120**

FROM	TO	LITHOLOGIC LOG	FROM	TO	PLUGGING INTERVALS
0	2	Top soil, black			
2	5	Clay, light brown, silty			
5	16	Clay, brown, silty			
16	20	Silt, brown, clayey			
20	35	Clay, greyish brown, silty			

7 CONTRACTOR'S OR LANDOWNER'S CERTIFICATION: This water well was **1** constructed (2) reconstructed, or (3) plugged under my jurisdiction and was completed on (mo/day/year)8-22-91..... and this record is true to the best of my knowledge and belief. Kansas Water Well Contractor's License No.527..... This Water Well Record was completed on (mo/day/yr)8-28-91..... under the business name of **GeoCore Services, Inc.** by (signature) *Don Roll*

OFFICE USE ONLY T R EW SEC 1/4 1/4 1/4