

1 LOCATION OF WATER WELL: County: Dickinson Fraction NW 1/4 NW 1/4 NE 1/4 Section Number 21 Township Number T 13 S Range Number R 2 EW

Distance and direction from nearest town or city street address of well if located within city?

102 S Buckeye, Abilene, Kansas

MW 11

2 WATER WELL OWNER: Mr. Clyde Howard


RR#, St. Address, Box #: 102 S Buckeye

Board of Agriculture, Division of Water Resources

City, State, ZIP Code: Abilene, Ks

Application Number:

3 LOCATE WELL'S LOCATION WITH AN "X" IN SECTION BOX:

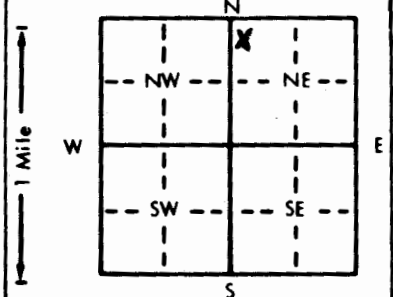

4 DEPTH OF COMPLETED WELL: 35 ft. ELEVATION:

Depth(s) Groundwater Encountered 1. ft. 2. ft. 3. ft.

WELL'S STATIC WATER LEVEL 27.08 ft. below land surface measured on mo/day/yr 8-26-91

Pump test data: Well water was ft. after hours pumping gpm

Est. Yield gpm: Well water was ft. after hours pumping gpm

Bore Hole Diameter: 7.5/8 in. to 35 ft., and in. to ft.

WELL WATER TO BE USED AS: 5 Public water supply 8 Air conditioning 11 Injection well

1 Domestic 3 Feedlot 6 Oil field water supply 9 Dewatering 12 Other (Specify below)

2 Irrigation 4 Industrial 7 Lawn and garden only 10 Monitoring well

Was a chemical/bacteriological sample submitted to Department? Yes No x; If yes, mo/day/yr sample was submitted

Water Well Disinfected? Yes x No

5 TYPE OF BLANK CASING USED:

- 1 Steel 3 RMP (SR) 5 Wrought iron 8 Concrete tile CASING JOINTS: Glued Clamped
- 2 PVC 4 ABS 6 Asbestos-Cement 9 Other (specify below) Welded
- 7 Fiberglass Threaded

Blank casing diameter: 2 in. to 20 ft., Dia. in. to ft., Dia. in. to ft.

Casing height above land surface: 0 in., weight lbs./ft. Wall thickness or gauge No. Schedule 40

TYPE OF SCREEN OR PERFORATION MATERIAL:

- 1 Steel 3 Stainless steel 5 Fiberglass 7 PVC 10 Asbestos-cement
- 2 Brass 4 Galvanized steel 6 Concrete tile 8 RMP (SR) 11 Other (specify)
- 9 ABS 12 None used (open hole)

SCREEN OR PERFORATION OPENINGS ARE:

- 1 Continuous slot 3 Mill slot 5 Gauzed wrapped 8 Saw cut 11 None (open hole)
- 2 Louvered shutter 4 Key punched 6 Wire wrapped 9 Drilled holes
- 7 Torch cut 10 Other (specify)

SCREEN-PERFORATED INTERVALS: From 20 ft. to 35 ft., From ft. to ft.

From ft. to ft., From ft. to ft.

GRAVEL PACK INTERVALS: From 18 ft. to 35 ft., From ft. to ft.

From ft. to ft., From ft. to ft.

6 GROUT MATERIAL: 1 Neat cement 2 Cement grout 3 Bentonite 4 Other

Grout intervals: From 0 ft. to 1 (cement) ft., From 1 ft. to 18 (bent) ft., From ft. to ft.

What is the nearest source of possible contamination:

- 1 Septic tank 4 Lateral lines 7 Pit privy 10 Livestock pens 14 Abandoned water well
- 2 Sewer lines 5 Cess pool 8 Sewage lagoon 11 Fuel storage 15 Oil well/Gas well
- 3 Watertight sewer lines 6 Seepage pit 9 Feedyard 12 Fertilizer storage 16 Other (specify below)
- 13 Insecticide storage

Direction from well? NW

How many feet? 300

FROM	TO	LITHOLOGIC LOG	FROM	TO	PLUGGING INTERVALS
0	1	Top soil, black			
1	6	Clay, light brown, silty			
6	8	Clay, tan, silty			
8	14	Clay, brown, silty			
14	17	Silt, light brown, clayey			
17	25	Clay, dark brown, clayey			
25	30	Clay, light brown, clayey			
30	35	Sand, yellow, fine			

7 CONTRACTOR'S OR LANDOWNER'S CERTIFICATION: This water well was (1) constructed, (2) reconstructed, or (3) plugged under my jurisdiction and completed on (mo/day/year) 8-22-91 and this record is true to the best of my knowledge and belief. Kar

Water Well Contractor's License No. 527 This Water Well Record was completed on (mo/day/yr) 8-29-91

under the business name of GeoCore Services, Inc.

by (signature) Dale Bell

INSTRUCTIONS: Use typewriter or ball point pen. PLEASE PRESS FIRMLY and PRINT clearly. Please fill in blanks, underline or circle the correct answers. Send top three copies to Kansas Department of Health and Environment, Bureau of Water, Topeka, Kansas 66620-0001. Telephone: 913-296-5545. Send one to WATER WELL OWNER and retain one for your records.