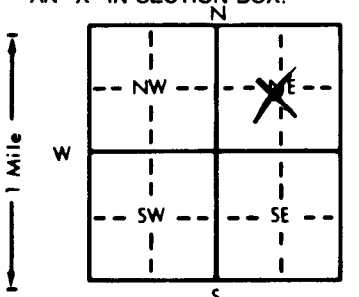


1 LOCATION OF WATER WELL: County: <u>Dickinson</u> Fraction <u>Near 1/4 Center 1/4 NE 1/4</u> Section Number <u>23</u> Township Number <u>T 13 S</u> Range Number <u>R 2</u> <input checked="" type="checkbox"/> W
--

Distance and direction from nearest town or city street address of well if located within city?
1 3/4 Mile East of Abilene, KS

2 WATER WELL OWNER: <u>Terry Whitehair</u> RR#, St. Address, Box # : <u>R.R. 5</u> City, State, ZIP Code : <u>Abilene, KS 67410</u>	Board of Agriculture, Division of Water Resources Application Number: <u>40,230</u>
---	--

3 LOCATE WELL'S LOCATION WITH AN "X" IN SECTION BOX: 	4 DEPTH OF COMPLETED WELL: <u>60</u> ft. ELEVATION: Depth(s) Groundwater Encountered 1. <u>21</u> ft. 2. ft. 3. ft. WELL'S STATIC WATER LEVEL <u>21</u> ft. below land surface measured on mo/day/yr <u>10-29-91</u> Pump test data: Well water was ft. after hours pumping gpm Est. Yield <u>800-1000</u> : Well water was ft. after hours pumping gpm Bore Hole Diameter <u>30</u> in. to <u>60</u> ft., and in. to ft. WELL WATER TO BE USED AS: 5 Public water supply 8 Air conditioning 11 Injection well 1 Domestic 3 Feedlot 6 Oil field water supply 9 Dewatering 12 Other (Specify below) 2 Irrigation 4 Industrial 7 Lawn and garden only 10 Monitoring well Was a chemical/bacteriological sample submitted to Department? Yes.....No... <u>X</u>; If yes, mo/day/yr sample was submitted Water Well Disinfected? Yes <u>X</u> No
--	---

5 TYPE OF BLANK CASING USED: 1 Steel 3 RMP (SR) 2 PVC 4 ABS	5 Wrought iron 8 Concrete tile 6 Asbestos-Cement 9 Other (specify below) 7 Fiberglass	CASING JOINTS: Glued <u>X</u> Clamped Welded Threaded
Blank casing diameter <u>16</u> in. to <u>40</u> ft., Dia. in. to ft., Dia. in. to ft. Casing height above land surface <u>12</u> in., weight <u>16.15</u> lbs./ft. Wall thickness or gauge No. <u>500</u>	TYPE OF SCREEN OR PERFORATION MATERIAL: 1 Steel 3 Stainless steel 5 Fiberglass 7 PVC 10 Asbestos-cement 2 Brass 4 Galvanized steel 6 Concrete tile 8 RMP (SR) 11 Other (specify) 12 None used (open hole)	
SCREEN OR PERFORATION OPENINGS ARE: 1 Continuous slot 3 Mill slot 5 Gauzed wrapped 8 Saw cut 11 None (open hole) 2 Louvered shutter 4 Key punched 6 Wire wrapped 9 Drilled holes 7 Torch cut 10 Other (specify)	SCREEN-PERFORATED INTERVALS: From <u>40</u> ft. to <u>60</u> ft., From ft. to ft. From ft. to ft., From ft. to ft.	
GRAVEL PACK INTERVALS: From <u>20</u> ft. to <u>60</u> ft., From ft. to ft. From ft. to ft., From ft. to ft.		

6 GROUT MATERIAL: 1 Neat cement 2 <u>Cement grout</u> 3 Bentonite 4 Other
Grout Intervals: From <u>0</u> ft. to <u>20</u> ft., From ft. to ft., From ft. to ft.
What is the nearest source of possible contamination: 1 Septic tank 4 Lateral lines 7 Pit privy 10 Livestock pens 14 Abandoned water well 2 Sewer lines 5 Cess pool 8 Sewage lagoon 11 <u>Fuel storage</u> 15 Oil well/Gas well 3 Watertight sewer lines 6 Seepage pit 9 Feedyard 12 Fertilizer storage 16 Other (specify below) 13 Insecticide storage
Direction from well? <u>North</u> How many feet? <u>1000 ft</u>

FROM	TO	LITHOLOGIC LOG	FROM	TO	PLUGGING INTERVALS
0	5	Top Soil			
5	20	Tan Clay			
20	27	Sandrock With Fine Sand			
27	31	Gray Sandrock with Fine Sand			
31	55	Medium Sand			
55	59	Medium to Course Sand			
59	60	Limestone			
60		Red Shale			

7 CONTRACTOR'S OR LANDOWNER'S CERTIFICATION: This water well was (1) <u>constructed</u> , (2) reconstructed, or (3) plugged under my jurisdiction and was completed on (mo/day/year) <u>10-29-91</u> and this record is true to the best of my knowledge and belief. Kansas Water Well Contractor's License No. <u>138</u> . This Water Well Record was completed on (mo/day/yr) <u>11-4-91</u> under the business name of <u>Peterson Irrigation, Inc.</u> by (signature) <u>Mike Peterson</u>

OFFICE USE ONLY
T
R
EW
SEC.
1/4
1/4
1/4