


1 LOCATION OF WATER WELL: County: **Dickinson** Fraction: **NW 1/4 SW 1/4 NE 1/4** Section Number: **33** Township Number: **T 13 S** Range Number: **R 2 EW**

Distance and direction from nearest town or city street address of well if located within city?
KPL Abilene Compressor Station - 2 mi south of Abilene on Hwy 15

2 WATER WELL OWNER: **Kansas Power & Light**
 RR#, St. Address, Box #: **818 Kansas Ave** Board of Agriculture, Division of Water Resources
 City, State, ZIP Code: **Topeka, Ks 66612** Application Number:

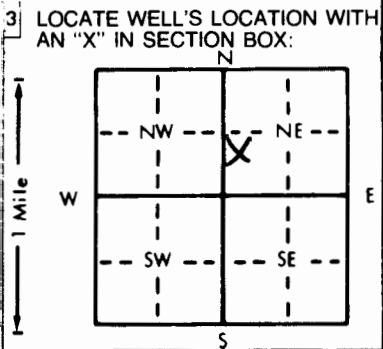

4 DEPTH OF COMPLETED WELL: **25** ft. ELEVATION:
 Depth(s) Groundwater Encountered 1. ft. 2. ft. 3. ft.
 WELL'S STATIC WATER LEVEL ft. below land surface measured on mo/day/yr
 Pump test data: Well water was ft. after hours pumping gpm
 Est. Yield gpm: Well water was ft. after hours pumping gpm
 Bore Hole Diameter: **7.5** in. to **2.5** ft., and in. to ft.
 WELL WATER TO BE USED AS: 5 Public water supply 8 Air conditioning 11 Injection well
 1 Domestic 3 Feedlot 6 Oil field water supply 9 Dewatering 12 Other (Specify below)
 2 Irrigation 4 Industrial 7 Lawn and garden only **10 Monitoring well**
 Was a chemical/bacteriological sample submitted to Department? Yes.....No..... If yes, mo/day/yr sample was submitted
 Water Well Disinfected? Yes No

5 TYPE OF BLANK CASING USED: 5 Wrought iron 8 Concrete tile CASING JOINTS: Glued Clamped
1 Steel stainless RMP (SR) 6 Asbestos-Cement 9 Other (specify below) Welded
2 PVC 4 ABS 7 Fiberglass Threaded.....
 Blank casing diameter **2**" PVC to **13** ft., Dia **2**" stainless so **23-25** ft., Dia in. to ft.
 Casing height above land surface **24** in., weight lbs./ft. Wall thickness or gauge No. **Sch. 40**
 TYPE OF SCREEN OR PERFORATION MATERIAL: 7 PVC 10 Asbestos-cement
 1 Steel **3 Stainless steel** 5 Fiberglass 8 RMP (SR) 11 Other (specify)
 2 Brass 4 Galvanized steel 6 Concrete tile 9 ABS 12 None used (open hole)
 SCREEN OR PERFORATION OPENINGS ARE: 5 Gauzed wrapped 8 Saw cut 11 None (open hole)
 1 Continuous slot 3 Mill slot **6 Wire wrapped** 9 Drilled holes
 2 Louvered shutter 4 Key punched 7 Torch cut 10 Other (specify)
 SCREEN-PERFORATED INTERVALS: From **23** ft. to **13** ft., From ft. to ft.
 From ft. to ft., From ft. to ft.
 GRAVEL PACK INTERVALS: From **25** ft. to **12** ft., From ft. to ft.
 From ft. to ft., From ft. to ft.

6 GROUT MATERIAL: 1 Neat cement **2 Cement grout** **3 Bentonite** 4 Other
 Grout Intervals: From **12** ft. to **3** (bent), From **3** ft. to **0** (cement), From ft. to ft.
 What is the nearest source of possible contamination: 10 Livestock pens 14 Abandoned water well
 1 Septic tank 4 Lateral lines 7 Pit privy 11 Fuel storage 15 Oil well/Gas well
 2 Sewer lines 5 Cess pool 8 Sewage lagoon 12 Fertilizer storage **16 Other (specify below)**
 3 Watertight sewer lines 6 Seepage pit 9 Feedyard 13 Insecticide storage **Abandoned - closed lagoon**
 Direction from well? How many feet? **lagoon**

FROM	TO	LITHOLOGIC LOG	FROM	TO	PLUGGING INTERVALS
0	7	Clay			MW-G
7	8	Clay - sandy			Completion
8	13	Clay	25	23	2" STAINLESS STEEL SUMP
13	18	Silt - sandy	23	13	2" STAINLESS STEEL SCREEN
18	18.5	Silt - firm	13	0	2" PVC RISER
18.5	25	Sand silty	25	12	Gravel pack, 10-20 Co. Si. sand
25		Shale - buff	12	10	3/8 bent pellets
25		Total Depth	10	3	Volclay bent grout
			3	0	Cement
					4'x4'x6" concrete pad at surface with 6" lockable protective steel cover

7 CONTRACTOR'S OR LANDOWNER'S CERTIFICATION: This water well was **(1) constructed** (2) reconstructed, or (3) plugged under my jurisdiction and was completed on (mo/day/year) **6-28-90** and this record is true to the best of my knowledge and belief. Kansas Water Well Contractor's License No. **527** This Water Well Record was completed on (mo/day/yr) **8-27-90** under the business name of **GeoCore Services, Inc.** by (signature) *Dale A. Bell*

OFFICE USE ONLY
T
R
SEC.
1/4
1/4
1/4