


1 LOCATION OF WATER WELL: Fraction SE 1/4 NE 1/4 NE 1/4 Section Number 5 Township Number T 13 S Range Number R 2 EA*

Distance and direction from nearest town or city street address of well if located within city?
 From Abilene, Ks on Hwy 15 & 1st go North on Hwy 15 2 miles N. 1/2 West 3/4 N.

2 WATER WELL OWNER: Don Hunt
 RR#, St. Address, Box #: 1232 2600 Ave. Board of Agriculture, Division of Water Resources
 City, State, ZIP Code: Abilene, Kansas 67410 Application Number:

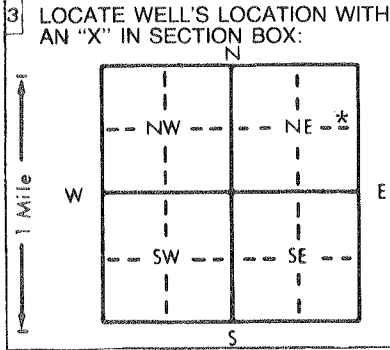

4 DEPTH OF COMPLETED WELL: 70 ft. ELEVATION:
 Depth(s) Groundwater Encountered 1. 63 ft. 2. ft. 3. ft.
 WELL'S STATIC WATER LEVEL: 32 ft. below land surface measured on mo/day/yr 4. / .25. / .97.
 Pump test data: Well water was ft. after hours pumping gpm
 Est. Yield: 25 gpm; Well water was ft. after hours pumping gpm
 Bore Hole Diameter: 9 in. to 70 ft., and in. to ft.
 WELL WATER TO BE USED AS: 5 Public water supply 8 Air conditioning 11 Injection well
 1 Domestic 3 Feedlot 6 Oil field water supply 9 Dewatering 12 Other (Specify below)
 2 Irrigation 4 Industrial 7 Lawn and garden only 10 Monitoring well
 Was a chemical/bacteriological sample submitted to Department? Yes.....No.*.....; If yes, mo/day/yr sample was submitted Water Well Disinfected? Yes * No

5 TYPE OF BLANK CASING USED:
 1 Steel 3 RMP (SR) 5 Wrought iron 8 Concrete tile CASING JOINTS: Glued * Clamped
 2 PVC 4 ABS 6 Asbestos-Cement 9 Other (specify below) Welded
 7 Fiberglass Threaded
 Blank casing diameter: 5 in. to 70 ft. Dia. in. to ft. Dia. in. to ft.
 Casing height above land surface: 14 in., weight 1.60 lbs./ft. Wall thickness or gauge No. 214
 TYPE OF SCREEN OR PERFORATION MATERIAL:
 1 Steel 3 Stainless steel 5 Fiberglass 8 RMP (SR) 10 Asbestos-cement
 2 Brass 4 Galvanized steel 6 Concrete tile 9 ABS 11 Other (specify)
 12 None used (open hole)
 SCREEN OR PERFORATION OPENINGS ARE:
 1 Continuous slot 3 Mill slot 5 Gauzed wrapped 8 Saw cut 11 None (open hole)
 2 Louvered shutter 4 Key punched 6 Wire wrapped 9 Drilled holes
 7 Torch cut 10 Other (specify)
 SCREEN-PERFORATED INTERVALS: From 59 ft. to 70 ft., From ft. to ft.
 GRAVEL PACK INTERVALS: From 24 ft. to 70 ft., From ft. to ft.

6 GROUT MATERIAL: 1 Neat cement 2 Cement grout 3 Bentonite 4 Other
 Grout Intervals: From 3 ft. to 24 ft., From ft. to ft., From ft. to ft.
 What is the nearest source of possible contamination:
 1 Septic tank 4 Lateral lines 7 Pit privy 10 Livestock pens 14 Abandoned water well
 2 Sewer lines 5 Cess pool 8 Sewage lagoon 11 Fuel storage 15 Oil well/Gas well
 3 Watertight sewer lines 6 Seepage pit 9 Feedyard 12 Fertilizer storage 16 Other (specify below)
 13 Insecticide storage
 Direction from well? NORTHWEST APPROX How many feet? 150

FROM	TO	LITHOLOGIC LOG	FROM	TO	PLUGGING INTERVALS
0	1	DARK TOP SOIL			
1	10	BROWN CLAY			
10	16	TAN CLAY			
16	22	LITE COLOR CLAY & SHALE & LIMESTONE			
22	26	LITE COLOR SHALE			
26	31	LITE COLOR LIMESTONE			
31	42	GRAY CLAY & SHALE			
42	43	HARD GRAY LIMESTONE			
43	50	GRAY SHALE			
50	61	RED & BROWN SHALE & CLAY			
61	64	GRAY SHALE			
64	65	HARD GRAY LIMESTONE			
65	70	GRAY SHALE			

7 CONTRACTOR'S OR LANDOWNER'S CERTIFICATION: This water well was (1) constructed, (2) reconstructed, or (3) plugged under my jurisdiction and was completed on (mo/day/year) 4 / 25 / 97 and this record is true to the best of my knowledge and belief. Kansas Water Well Contractor's License No. 397 This Water Well Record was completed on (mo/day/yr) 5 / 1 / 97 under the business name of CENTRAL KANSAS DRILLING by (signature) Harold D. Martin