


1 LOCATION OF WATER WELL: County: **DICKINSON** Fraction: **NE 1/4 NE 1/4 SW 1/4** Section Number: **9** Township Number: **T 13 S** Range Number: **R 2 E/W**

Distance and direction from nearest town or city street address of well if located within city? **2200N BUCKEYE**

2 WATER WELL OWNER: **AMACO** RR#, St. Address, Box #: **2200 N BUCKEYE** Board of Agriculture, Division of Water Resources City, State, ZIP Code: **ABILENE KS** Application Number:

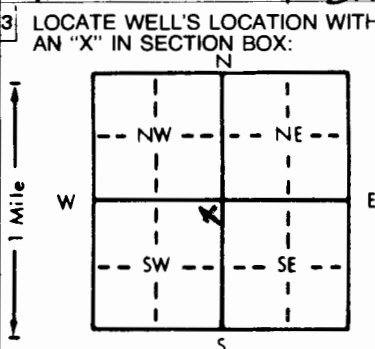

4 DEPTH OF COMPLETED WELL: **60** ft. ELEVATION: Depth(s) Groundwater Encountered: 1. **999** ft. 2. ft. 3. ft. WELL'S STATIC WATER LEVEL: **999** ft. below land surface measured on mo/day/yr Pump test data: Well water was ft. after hours pumping gpm Est. Yield gpm: Well water was ft. after hours pumping gpm Bore Hole Diameter: **10** in. to **38** ft., and **4** in. to **60** ft. WELL WATER TO BE USED AS: 5 Public water supply 8 Air conditioning 11 Injection well 1 Domestic 3 Feedlot 6 Oil field water supply 9 Dewatering 12 Other (Specify below) 2 Irrigation 4 Industrial 7 Lawn and garden only **10 Monitoring well** Was a chemical/bacteriological sample submitted to Department? Yes No If yes, mo/day/yr sample was submitted Water Well Disinfected? Yes No

5 TYPE OF BLANK CASING USED: 1 Steel 3 RMP (SR) 5 Wrought iron 8 Concrete tile CASING JOINTS: Glued Clamped 2 **PVC** 4 ABS 6 Asbestos-Cement 9 Other (specify below) Welded 7 Fiberglass Threaded Blank casing diameter: **4** in. to **38** ft., Dia **2** in. to **60** ft., Dia Casing height above land surface: in., weight lbs./ft. Wall thickness or gauge No.

TYPE OF SCREEN OR PERFORATION MATERIAL: 1 Steel 3 Stainless steel 5 Fiberglass 7 **PVC** 10 Asbestos-cement 2 Brass 4 Galvanized steel 6 Concrete tile 8 RMP (SR) 11 Other (specify) 12 None used (open hole)

SCREEN OR PERFORATION OPENINGS ARE: 1 Continuous slot 3 **Mill slot** 5 Gauzed wrapped 8 Saw cut 11 None (open hole) 2 Louvered shutter 4 Key punched 6 Wire wrapped 9 Drilled holes 7 Torch cut 10 Other (specify)

SCREEN-PERFORATED INTERVALS: From **50** ft. to **60** ft., From ft. to ft. From ft. to ft. From ft. to ft. GRAVEL PACK INTERVALS: From **43** ft. to **60** ft., From ft. to ft. From ft. to ft.

6 GROUT MATERIAL: 1 Neat cement 2 **Cement grout** 3 Bentonite 4 Other Grout Intervals: From **0** ft. to **42** ft., From ft. to ft., From ft. to ft.

What is the nearest source of possible contamination: 1 Septic tank 4 Lateral lines 7 Pit privy 10 **Livestock pens** 14 Abandoned water well 2 Sewer lines 5 Cess pool 8 Sewage lagoon 11 **Fuel storage** 15 Oil well/Gas well 3 Watertight sewer lines 6 Seepage pit 9 Feedyard 12 Fertilizer storage 16 Other (specify below) 13 Insecticide storage

Direction from well? **UNKNOWN** How many feet? **< 1001**

FROM	TO	LITHOLOGIC LOG	FROM	TO	PLUGGING INTERVALS
0	38	Shale & Clay			
38	60	Lime stone			
Approved by D. Plummer for late submittal 4/10/91					

7 CONTRACTOR'S OR LANDOWNER'S CERTIFICATION: This water well was **(1)** constructed, (2) reconstructed, or (3) plugged under my jurisdiction and was completed on (mo/day/year) **11/30/90** and this record is true to the best of my knowledge and belief. Kansas Water Well Contractor's License No. **102** This Water Well Record was completed on (mo/day/yr) **4/16/91** under the business name of **Gayne Western Co Inc** by (signature) **B Meier**

INSTRUCTIONS: Use typewriter or ball point pen. PLEASE PRESS FIRMLY and PRINT clearly. Please fill in blanks, underline or circle the correct answers. Send top three copies to Kansas Department of Health and Environment, Bureau of Water, Topeka, Kansas 66620-7320. Telephone: 913-296-5545. Send one to WATER WELL OWNER and retain one for your records.

1810921005-22