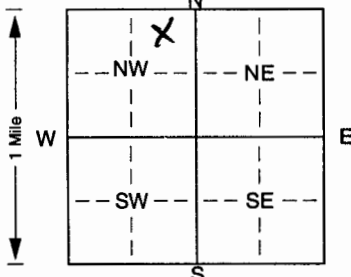


ABMW 3

1 LOCATION OF WATER WELL: County: <u>DICKINSON</u>	Fraction <u>NE 1/4 NW 1/4 NW 1/4</u>	Section Number <u>21</u>	Township Number T <u>13</u> S	Range Number R <u>2</u> <u>E/W</u>
---	---	-----------------------------	----------------------------------	---------------------------------------

Distance and direction from nearest town or city street address of well if located within city?
S. MULBERRY ST. AND SW. 2ND ST., ABILENE, KS

2 WATER WELL OWNER: <u>ONEOK, INC.</u> RR#, St. Address, Box # : <u>S. MULBERRY ST. & SW. 2ND ST.</u> City, State, ZIP Code : <u>ABILENE, KS 67410</u>	Board of Agriculture, Division of Water Resources Application Number:
--	--

3 LOCATE WELL'S LOCATION WITH AN "X" IN SECTION BOX: 	4 DEPTH OF COMPLETED WELL: <u>25.0</u> ft. ELEVATION: Depth(s) Groundwater Encountered 1. ft. 2. ft. 3. ft. WELL'S STATIC WATER LEVEL ft. below land surface measured on mo/day/yr Pump test data: Well water was ft. after hours pumping gpm Est. Yield gpm: Well water was ft. after hours pumping gpm Bore Hole Diameter. in. to ft., and in. to ft. WELL WATER TO BE USED AS: 5 Public water supply 8 Air conditioning 11 Injection well 1 Domestic 3 Feedlot 6 Oil field water supply 9 Dewatering 12 Other (Specify below) 2 Irrigation 4 Industrial 7 Domestic (lawn & garden) <u>10 Monitoring well</u> Was a chemical/bacteriological sample submitted to Department? Yes. No. <u>X</u> ; If yes, mo/day/yr sample was submitted Water Well Disinfected? Yes No
--	---

5 TYPE OF BLANK CASING USED: 1 Steel <u>2 PVC</u> 3 RMP (SR) 4 ABS Blank casing diameter <u>2</u> in. to <u>10</u> ft., Dia in. to ft., Dia in. to ft. Casing height above land surface. in., weight <u>SCH 40</u> lbs./ft. Wall thickness or gauge No.	5 Wrought iron 6 Asbestos-Cement 7 Fiberglass 8 Concrete tile 9 Other (specify below) CASING JOINTS: Glued. Clamped. Welded Threaded. <u>X</u>
TYPE OF SCREEN OR PERFORATION MATERIAL: 1 Steel 2 Brass SCREEN OR PERFORATION OPENINGS ARE: 1 Continuous slot 2 Louvered shutter SCREEN-PERFORATED INTERVALS: From <u>25.0</u> ft. to <u>10.0</u> ft., From ft. to ft. GRAVEL PACK INTERVALS: From <u>25.0</u> ft. to <u>7.5</u> ft., From ft. to ft.	3 Stainless steel 4 Galvanized steel 5 Gauzed wrapped 6 Wire wrapped 7 Torch cut 8 RMP (SR) <u>7 PVC</u> 9 ABS 10 Asbestos-cement 11 Other (specify) 12 None used (open hole) 8 Saw cut 9 Drilled holes 10 Other (specify) 11 None (open hole)

6 GROUT MATERIAL: 1 Neat cement 2 Cement grout <u>3 Bentonite</u> 4 Other Grout Intervals: From <u>7.5</u> ft. to <u>1.0</u> ft., From ft. to ft., From ft. to ft. What is the nearest source of possible contamination: 1 Septic tank 4 Lateral lines 7 Pit privy 10 Livestock pens 14 Abandoned water well 2 Sewer lines 5 Cess pool 8 Sewage lagoon 11 Fuel storage 15 Oil well/Gas well 3 Watertight sewer lines 6 Seepage pit 9 Feedyard 12 Fertilizer storage 16 Other (specify below) 13 Insecticide storage Direction from well? How many feet?
--

FROM	TO	LITHOLOGIC LOG	FROM	TO	PLUGGING INTERVALS
0	0.5	GRAVEL			
0.5	7.5	SILT, SOME SAND, BROWN, MED. GRAINED			
7.5	12	SAND, DK. YELLOWISH BROWN, MED. GRAINED, CLAY STAINS PRESENT			
12	15.5	INTERBEDDED SILTY CLAY AND SAND (MED TO COARSE GRAINED)			
15.5	25	CLAYEY SILT, BROWN			
19	25	SILTY CLAY, DK. GRAYISH BROWN			

7 CONTRACTOR'S OR LANDOWNER'S CERTIFICATION: This water well was (1) constructed, (2) reconstructed, or (3) plugged under my jurisdiction and was completed on (mo/day/year) <u>10-13-04</u> and this record is true to the best of my knowledge and belief. Kansas Water Well Contractor's Licence No. <u>529</u> This Water Well Record was completed on (mo/day/yr) <u>12/22/04</u> under the business name of <u>GEOTECHNOLOGY, INC.</u> by (signature) <u>[Signature]</u>
--