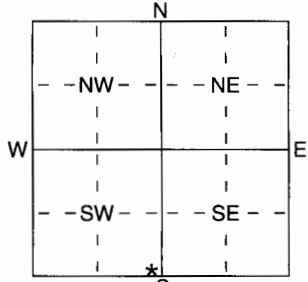


1 LOCATION OF WATER WELL: Fraction NE 1/4 SE 1/4 SW 1/4 Section Number 9 Township Number T 13 S Range Number R 2 EAW
 County: Dickinson

Distance and direction from nearest town or city street address of well if located within city?
In Abilene, Ks at 203 Summit Dr.

2 WATER WELL OWNER: Sandy Willey
 RR#, St. Address, Box # : 203 Summit Dr Board of Agriculture, Division of Water Resources
 City, State, ZIP Code : Abilene, Kansas 67410 Application Number:

3 LOCATE WELL'S LOCATION WITH AN "X" IN SECTION BOX: 4 DEPTH OF COMPLETED WELL 8.1 ft. ELEVATION:

 Depth(s) Groundwater Encountered 1 4.8 ft. 2 ft. 3 ft.
 WELL'S STATIC WATER LEVEL 4.0 ft. below land surface measured on mo/day/yr 8 / 4 / 0.5
 Pump test data: Well water was ft. after hours pumping gpm
 Est. Yield 3.4 gpm: Well water was ft. after hours pumping gpm
 WELL WATER TO BE USED AS: 5 Public water supply 8 Air conditioning 11 Injection well
 1 Domestic 3 Feedlot 6 Oil field water supply 9 Dewatering 12 Other (Specify below)
 2 Irrigation 4 Industrial 7 Domestic (lawn & garden) 10 Monitoring well
 Was a chemical/bacteriological sample submitted to Department? Yes No *; If yes, mo/day/yr sample was sub-
 mitted Water Well Disinfected? Yes * No

5 TYPE OF BLANK CASING USED: 5 Wrought iron 8 Concrete tile CASING JOINTS: Glued * Clamped
 1 Steel 3 RMP (SR) 6 Asbestos-Cement 9 Other (specify below) Welded
 2 PVC 4 ABS 7 Fiberglass Threaded
 Blank casing diameter 5 in. to 8.1 ft., Dia in. to ft., Dia in. to ft.
 Casing height above land surface 1.4 in., weight 2.00 lbs./ft. Wall thickness or guage No. 2.5.0
 TYPE OF SCREEN OR PERFORATION MATERIAL: 7 PVC 10 Asbestos-Cement
 1 Steel 3 Stainless Steel 5 Fiberglass 8 RMP (SR) 11 Other (Specify)
 2 Brass 4 Galvanized Steel 6 Concrete tile 9 ABS 12 None used (open hole)
 SCREEN OR PERFORATION OPENINGS ARE: 5 Guazed wrapped 8 Saw cut 11 None (open hole)
 1 Continuous slot 3 Mill slot 6 Wire wrapped 9 Drilled holes
 2 Louvered shutter 4 Key punched 7 Torch cut 10 Other (specify) ft.
 SCREEN-PERFORATED INTERVALS: From 4.1 ft. to 8.1 ft., From ft. to ft.
 From ft. to ft., From ft. to ft.
 GRAVEL PACK INTERVALS: From 2.3 1/2 ft. to 8.1 ft., From ft. to ft.
 From ft. to ft., From ft. to ft.

6 GROUT MATERIAL: 1 Neat cement 2 Cement grout 3 Bentonite 4 Other
 Grout Intervals: From 3 ft. to 2.3 1/2 ft., From ft. to ft., From ft. to ft.
 What is the nearest source of possible contamination: 10 Livestock pens 14 Abandoned water well
 1 Septic tank 4 Lateral lines 7 Pit privy 11 Fuel storage 15 Oil well/Gas well
 2 Sewer lines 5 Cess pool 8 Sewage lagoon 12 Fertilizer storage 16 Other (specify below)
 3 Watertight sewer lines 6 Seepage pit 9 Feedyard 13 Insecticide storage

Direction from well? NORTH APPROX How many feet? 100

FROM	TO	LITHOLOGIC LOG	FROM	TO	PLUGGING INTERVALS
0	17	BROWN CLAY			
17	22	LITE COLOR CLAY			
22	24	LITE COLOR & LITE GRAY MIXED CLAY			
24	25	LITE COLOR LIMESTONE			
25	26	LITE COLOR SHALE			
26	27	HARD LIMESTONE			
27	31	GRAY SHALE			
31	48	RED SHALE			
48	51	LITE COLOR SHALE			
51	57	HARD LITE COLOR LIMESTONE			
57	70	GRAY LIMESTONE			
70	81	GRAY SHALE			

7 CONTRACTOR'S OR LANDOWNER'S CERTIFICATION: This water well was (1) constructed, (2) reconstructed, or (3) plugged under my jurisdiction and was completed on (mo/day/year) 8 / 4 / 05 and this record is true to the best of my knowledge and belief. Kansas Water Well Contractor's Licence No 3.9.7 This Water Well Record was completed on (mo/day/yr) 8 / 9 / 05 under the business name of CENTRAL KANSAS DRILLING by (signature) Harold D. Martin