


Wichita 10-7-05

1 LOCATION OF WATER WELL: County: **Dickinson** Fraction: **SW 1/4 SE 1/4 SW 1/4** Section Number: **16** Township Number: **T 13 S** Range Number: **R 2** (E)W

Distance and direction from nearest town or city street address of well if located within city?
Abilene Antique Plaza, 420 NW 2nd St., Abilene, Ks

2 WATER WELL OWNER: **Sally Rice Collingwood**
 RR#, St. Address, Box #: **36 Stratford Rd** Board of Agriculture, Division of Water Resources
 City, State, ZIP Code: **Wichita, Ks 67206** Application Number:

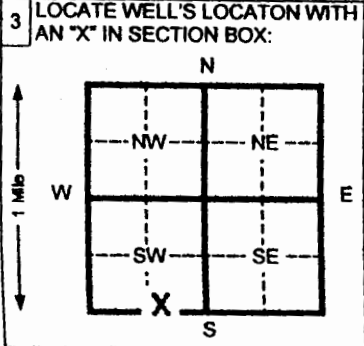

4 DEPTH OF COMPLETED WELL: **30.5** ft. ELEVATION: **4454.26 1155.68**

Depth(s) Groundwater Encountered: 1 _____ ft. 2 _____ ft. 3 _____ ft.

WELL'S STATIC WATER LEVEL: **22.4** ft. below land surface measured on mo/day/yr

Pump test data: Well water was _____ ft. after _____ hours pumping _____ gpm

Est. Yield _____ gpm: Well water was _____ ft. after _____ hours pumping _____ gpm

Bore Hole Diameter: **8.5** in. to **30.5** ft. and _____ in. to _____ ft.

WELL WATER TO BE USED AS: 5 Public water supply 8 Air conditioning 11 Injection well
 1 Domestic 3 Feed lot 6 Oil field water supply 9 Dewatering 12 Other (Specify below)
 2 Irrigation 4 Industrial 7 Lawn and garden (domestic) 10 Monitoring well

Was a chemical/bacteriological sample submitted to Department? Yes _____ No If yes, mo/day/yr sample was submitted _____

Water Well Disinfected? Yes _____ No

5 TYPE OF BLANK CASING USED: 1 Steel 3 RMP (SR) 5 Wrought Iron 8 Concrete tile CASING JOINTS: Glued _____ Clamped _____
 2 PVC 4 ABS 6 Asbestos-Cement 9 Other (specify below) Welded _____
 7 Fiberglass Threaded

Blank casing diameter: **2** in. to **15** ft., Dia _____ in. to _____ ft., Dia _____ in. to _____ ft.

Casing height above land surface: **0** in., weight **.716** lbs./ft. Wall thickness or gauge No. **.154**

TYPE OF SCREEN OR PERFORATION MATERIAL: 1 Steel 3 Stainless steel 5 Fiberglass 8 RMP (SR) 10 Asbestos-cement
 2 Brass 4 Galvanized steel 6 Concrete tile 9 ABS 11 Other (specify) _____
 12 None used (open hole)

SCREEN OR PERFORATION OPENINGS ARE: 5 Gauzed wrapped 8 Saw cut 11 None (open hole)
 1 Continuous slot 3 Mill slot 6 Wire wrapped 9 Drilled holes
 2 Louvered shutter 4 Key punched 7 Torch cut 10 Other (specify) _____

SCREEN-PERFORATED INTERVALS: From **15** ft. to **30** ft. From _____ ft. to _____ ft.
 From _____ ft. to _____ ft. From _____ ft. to _____ ft.

GRAVEL PACK INTERVALS: From **13** ft. to **30** ft. From _____ ft. to _____ ft.
 From _____ ft. to _____ ft. From _____ ft. to _____ ft.

6 GROUT MATERIAL: 1 Neat cement 2 Cement grout 3 Bentonite 4 Other

Grout intervals From **0** ft. to **2** ft. From **2** ft. to **13** ft. From _____ ft. to _____ ft.

What is the nearest source of possible contamination: 1 Septic tank 4 Lateral lines 7 Pit privy 10 Livestock pens 14 Abandoned water well
 2 Sewer lines 5 Cess pool 8 Sewage lagoon 11 Fuel storage 15 Oil well/ Gas well
 3 Watertight sewer lines 6 Seepage pit 9 Feedyard 12 Fertilizer storage 16 Other (specify below) _____
CONTAMINATED SITE

Direction from well? _____ How many feet? _____

FROM	TO	CODE	LITHOLOGIC LOG	FROM	TO	PLUGGING INTERVALS
0	.5		Asphalt			
.5	2		Silt, tr. Clay, sand & pebbles			
2	8		Fine sandy silt, tr clay			
8	12		Silt, tr clay			
12	18		Silt, tr, clay & fine sand			
18	22		Clayey silt			
22	30.5		Silt, trace clay			

7 CONTRACTOR'S OR LANDOWNER'S CERTIFICATION: This water well was (1) constructed, (2) reconstructed, or (3) plugged under my jurisdiction and was completed on (mo/day/yr) **10-5-2005** and this record is true to the best of my knowledge and belief. Kansas Water Well Contractor's License No. **554** This Water Well Record was completed on (mo/day/yr) **10-28-05** under the business name of **Woofter Pump & Well Inc.** by (signature) *Joey L. Woofter*

INSTRUCTIONS: Please fill in blanks and circle the correct answers. Send three copies to Kansas Department of Health and Environment, Bureau of Water, 1000 S W Jackson St., Ste. 420, Topeka, Kansas 66612-1367. Telephone: 913-296-5645. Send one to WATER WELL OWNER and retain one for your records.