


| | | | | |
|---------------------------|--|----------------|-----------------|--------------|
| 1 LOCATION OF WATER WELL: | Fraction | Section Number | Township Number | Range Number |
| County: <u>Dickinson</u> | <u>NW¹/₄ SW¹/₄ NW¹/₄</u> | <u>19</u> | <u>13</u> | <u>2E</u> |

Distance and direction from nearest town or city street address of well if located within city?
2 miles West of Abilene Ks

2 WATER WELL OWNER: City of Abilene c/o Cliff Gibbs
 RR #, St. Address, Box #: Box 519 Board of Agriculture, Division of Water Resources
 City, State, ZIP Code : Abilene, Ks 67410-0519 Application Number:

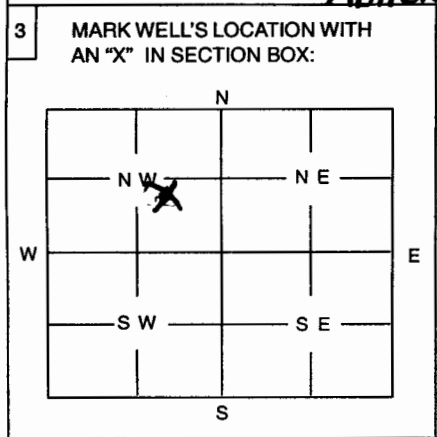

4 DEPTH OF WELL 43 ft
 WELL'S STATIC WATER LEVEL 26 ft

WELL WAS USED AS:

| | | |
|--------------|------------------------------|--------------------|
| 1 Domestic | <u>5 Public Water Supply</u> | 9 Dewatering |
| 2 Irrigation | 6 Oil Field Water Supply | 10 Monitoring Well |
| 3 Feedlot | 7 Domestic (Lawn & Garden) | 11 Injection Well |
| 4 Industrial | 8 Air Conditioning | 12 Other |

Was a chemical / bacteriological sample submitted to Department? Yes No X
 If yes, mo/day/yr sample was submitted

Water Well Disinfected: Yes X No

5 TYPE OF BLANK CASING USED:

| | | | | |
|----------------|------------|-------------------|-----------------|-------------------------|
| <u>1 Steel</u> | 3 RMP (SR) | 5 Wrought | 7 Fiberglass | 9 Other (Specify below) |
| 2 PVC | 4 ABS | 6 Asbestos-Cement | 8 Concrete Tile | |

Blank casing diameter 12 in. Was casing pulled? Yes No ✓ If yes, how much

Casing height above or below land surface 48 in.

6 GROUT PLUG MATERIAL: 1 Neat cement 2 Cement grout 3 Bentonite 4 Other

Grout Plug Intervals: From 4 ft. to 43 ft., From ft. to ft., From to ft.

What is the nearest source of possible contamination:

| | | | |
|--------------------------|-------------------|-------------------------|--------------------------|
| 1 <u>Septic tank</u> | 6 Seepage pit | 11 Fuel storage | 16 Other (specify below) |
| 2 <u>Sewer lines</u> | 7 Pit privy | 12 Fertilizer storage | |
| 3 Watertight sewer lines | 8 Sewage lagoon | 13 Insecticide storage | |
| 4 Lateral lines | 9 Feedyard | 14 Abandoned water well | |
| 5 Cess Pool | 10 Livestock pens | 15 Oil well/Gas well | |

Direction from well? Southwest How many feet? 550'

| FROM | TO | PLUGGING MATERIALS |
|----------|-----------|---------------------|
| <u>0</u> | <u>4</u> | <u>Top Soil</u> |
| <u>4</u> | <u>43</u> | <u>Cement grout</u> |
| | | |
| | | |
| | | |
| | | |

Abilene Water Well
#10 - Plugged

7 CONTRACTOR'S OR LANDOWNER'S CERTIFICATION: This water well was plugged under my jurisdiction and was completed on (mo/day/year) 11-21-05 and this record is true to the best of my knowledge and belief. Kansas Water Well Contractor's License No. 138 This Water Well Record was completed on (mo/day/year) 11-22-05 under the business name of PETERSON IRRIGATION by (signature) Mike Peterson

INSTRUCTIONS: Use typewriter or ball point pen. Please press firmly and print clearly. Please fill in blanks, underline or circle the correct answers. Send top three copies to Kansas Department of Health and Environment, Bureau of Water, Topeka, Kansas 66620-0001. Telephone: 785/296-3565. Send one to Water Well Owner and retain one for your records.