


1 LOCATION OF WATER WELL: Fraction Section Number Township Number Range Number
 County: Dickinson SE¼ NE¼ NE¼ 21 13 S 2 EW

Distance and direction from nearest town or city street address of well if located within city?
 509 SE 4th, Abilene

2 WATER WELL OWNER: Bert & Wetta Sales, Inc.
 PO Box 130
 RR #, St. Address, Box #: Larned, KS 67550
 City, State, ZIP Code : Board of Agriculture, Division of Water Resources
 Application Number:

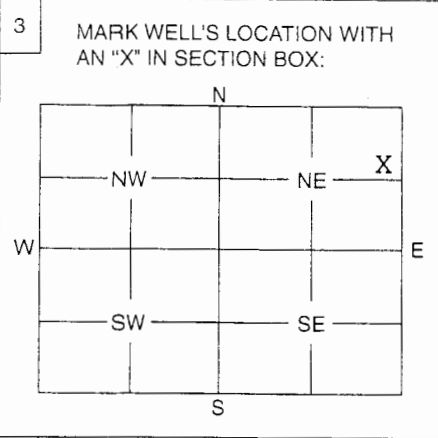

4 DEPTH OF WELL 20 ft.
 WELL'S STATIC WATER LEVEL Dry ft.
 WELL WAS USED AS:
 1 Domestic 5 Public Water Supply 9 Dewatering
 2 Irrigation 6 Oil Field Water Supply 10 Monitoring Well
 3 Feediot 7 Domestic (Lawn & Garden) 11 Injection Well
 4 Industrial 8 Air Conditioning 12 Other
 Was a chemical / bacteriological sample submitted to Department? Yes No X.....
 If yes, mo/day/yr sample was submitted
 Water Well Disinfected: Yes No X.....

5 TYPE OF BLANK CASING USED:
 1 Steel 3 RMP (SR) 5 Wrought 7 Fiberglass 9 Other (Specify below)
 2 PVC 4 ABS 6 Asbestos-Cement 8 Concrete Tile
 Blank casing diameter 2 in. Was casing pulled? Yes X..... No If yes, how much 10'
 Casing height above or below land surface n/a in.

6 GROUT PLUG MATERIAL: 1 Neat cement 2 Cement grout 3 Bentonite 4 Other Native soil and gravel
 Grout Plug Intervals: From 0 ft. to 0.5 ft., From 0.5 ft. to 20 ft., From to ft.
 What is the nearest source of possible contamination:
 1 Septic tank 6 Seepage pit 11 Fuel storage 16 Other (specify below) UST basin
 2 Sewer lines 7 Pit privy 12 Fertilizer storage
 3 Watertight sewer lines 8 Sewage lagoon 13 Insecticide storage
 4 Lateral lines 9 Feedyard 14 Abandoned water well
 5 Cess pool 10 Livestock pens 15 Oil well/Gas well
 Direction from well? How many feet?

FROM	TO	PLUGGING MATERIALS
0	0.5	Native soil and gravel
0.5	20	Bentonite (8")

MW13
 GeoCore #482
 KDHE #U5 021 10257

7 CONTRACTOR'S OF LANDOWNER'S CERTIFICATION: This water well was plugged under my jurisdiction and was completed on (mo/day/year) 11-22-2005 and this record is true to the best of my knowledge and belief. Kansas Water Well Contractor's License No. 527 This Water Well Record was completed on (mo/day/year) 11-30-2005 under the business name of GeoCore Inc.
 by (signature) *[Signature]*

INSTRUCTIONS: Use typewriter or ball point pen. Please press firmly and print clearly. Please fill in blanks, underline or circle the correct answers. Send top three copies to Kansas Department of Health and Environment, Bureau of Water, Geology Section, 1000 SW Jackson St., Ste. 420, Topeka, Kansas 66612-1367. Telephone: 785/296-5522. Send one to Water Well Owner and retain one for your records.