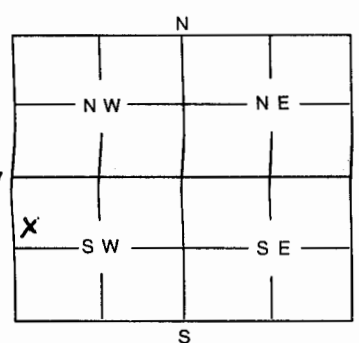


1 LOCATION OF WATER WELL: County: <u>Dickinson</u>	Fraction: <u>SW 1/4 NW 1/4 SW 1/4</u>	Section Number: <u>7</u>	Township Number: <u>13</u>	Range Number: <u>2 E</u>
---	---------------------------------------	--------------------------	----------------------------	--------------------------

Distance and direction from nearest town or city street address of well if located within city?
South side of East Bound on Ramp of I-70 2 West of Abilene

2 WATER WELL OWNER: <u>Malm Construction</u> RR #, St. Address, Box #: <u>State of Kansas</u> City, State, ZIP Code :	Board of Agriculture, Division of Water Resources Application Number:
---	--

3 MARK WELL'S LOCATION WITH AN "X" IN SECTION BOX: 	4 DEPTH OF WELL <u>28</u> ft. WELL'S STATIC WATER LEVEL <u>27</u> ft. WELL WAS USED AS: <table style="width:100%;"> <tr> <td>1 Domestic</td> <td>5 Public Water Supply</td> <td>9 Dewatering</td> </tr> <tr> <td>2 Irrigation</td> <td>6 Oil Field Water Supply</td> <td><input checked="" type="checkbox"/> 10 Monitoring Well</td> </tr> <tr> <td>3 Feedlot</td> <td>7 Domestic (Lawn & Garden)</td> <td>11 Injection Well</td> </tr> <tr> <td>4 Industrial</td> <td>8 Air Conditioning</td> <td>12 Other</td> </tr> </table> <p>Was a chemical / bacteriological sample submitted to Department? Yes No <u>X</u>..... If yes, mo/day/yr sample was submitted</p> <p>Water Well Disinfected: Yes <u>X</u> No</p>	1 Domestic	5 Public Water Supply	9 Dewatering	2 Irrigation	6 Oil Field Water Supply	<input checked="" type="checkbox"/> 10 Monitoring Well	3 Feedlot	7 Domestic (Lawn & Garden)	11 Injection Well	4 Industrial	8 

5 TYPE OF BLANK CASING USED:

1 Steel	3 RMP (SR)	5 Wrought	7 Fiberglass	9 Other (Specify below)
<input checked="" type="checkbox"/> 2 PVC	4 ABS	6 Asbestos-Cement	8 Concrete Tile

Blank casing diameter 2 in. Was casing pulled? Yes X No If yes, how much Top 3 FT
 Casing height above or below land surface 36" in.

6 GROUT PLUG MATERIAL: 1 Neat cement 2 Cement grout 3 Bentonite 4 Other

Grout Plug Intervals: From 3 ft. to 38 ft., From ft. to ft., From to ft.

What is the nearest source of possible contamination:

1 Septic tank	6 Seepage pit	11 Fuel storage	16 Other (specify below)
2 Sewer lines	7 Pit privy	12 Fertilizer storage	<u>None</u>
3 Watertight sewer lines	8 Sewage lagoon	13 Insecticide storage	
4 Lateral lines	9 Feedyard	14 Abandoned water well	
5 Cess Pool	10 Livestock pens	15 Oil well/Gas well	

Direction from well? How many feet?

FROM	TO	PLUGGING MATERIALS
0	3	<u>Top Soil</u>
3	38	<u>Bentonite Hole Plug</u>

7 CONTRACTOR'S OR LANDOWNER'S CERTIFICATION: This water well was plugged under my jurisdiction and was completed on (mo/day/year) 12-29-06 and this record is true to the best of my knowledge and belief. Kansas Water Well Contractor's License No. 138 This Water Well Record was completed on (mo/day/year) under the business name of Peterson Irrigation by (signature) Scott Baker

INSTRUCTIONS: Use typewriter or ball point pen. Please press firmly and print clearly. Please fill in blanks, underline or circle the correct answers. Send top three copies to Kansas Department of Health and Environment, Bureau of Water, Topeka, Kansas 66620-0001. Telephone: 785/296-3565. Send one to Water Well Owner and retain one for your records.