

1 LOCATION OF WATER WELL: County: DICKINSON Fraction: SE 1/4 SE 1/4 SE 1/4 Section Number: 17 Township Number: T 13 S Range Number: R 2

Distance and direction from nearest town or city street address of well if located within city? 301 N. VINE


2 WATER WELL OWNER: CORKY SERRAULT

RR#, St. Address, Box #: 301 N. VINE
City, State, ZIP Code: ABELINE, KS.

Board of Agriculture, Division of Water Resources
Application Number:

3 LOCATE WELL'S LOCATION WITH AN "X" IN SECTION BOX:

4 DEPTH OF COMPLETED WELL: 56 ft. ELEVATION:

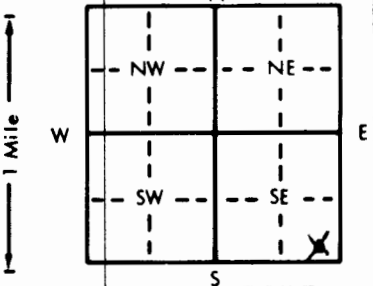

Depth(s) Groundwater Encountered 1. 46 ft. 2. _____ ft. 3. _____ ft.
WELL'S STATIC WATER LEVEL 21 ft. below land surface measured on mo/day/yr 10-21-81

Pump test data: Well water was _____ ft. after _____ hours pumping _____ gpm
Est. Yield 10-20 gpm: Well water was _____ ft. after _____ hours pumping _____ gpm
Bore Hole Diameter: 8 in. to 56 ft., and _____ in. to _____ ft.

WELL WATER TO BE USED AS:
5 Public water supply 8 Air conditioning 11 Injection well
1 Domestic 3 Feedlot 6 Oil field water supply 9 Dewatering 12 Other (Specify below)
2 Irrigation 4 Industrial Lawn and garden only 10 Observation well

Was a chemical/bacteriological sample submitted to Department? Yes _____ No _____; If yes, mo/day/yr sample was submitted
Water Well Disinfected? Yes _____ No _____

5 TYPE OF BLANK CASING USED:

Blank casing diameter 5 in. to 50 ft., Dia _____ in. to _____ ft., Dia _____ in. to _____ ft.
Casing height above land surface 12 in., weight 2.91 lbs./ft. Wall thickness or gauge No. 265

TYPE OF SCREEN OR PERFORATION MATERIAL:

SCREEN OR PERFORATION OPENINGS ARE:
1 Continuous slot 2 Louvered shutter 3 Mill slot 4 Key punched 5 Gauzed wrapped 6 Wire wrapped 7 Torch cut 8 Saw cut 9 Drilled holes 10 Other (specify) 11 None (open hole)

SCREEN-PERFORATED INTERVALS:

From 50 ft. to 56 ft., From _____ ft. to _____ ft.
From _____ ft. to _____ ft., From _____ ft. to _____ ft.

GRAVEL PACK INTERVALS:

From 16 ft. to 56 ft., From _____ ft. to _____ ft.
From _____ ft. to _____ ft., From _____ ft. to _____ ft.

6 GROUT MATERIAL:

Grout Intervals: From 0 ft. to 10 ft., From _____ ft. to _____ ft., From _____ ft. to _____ ft.

What is the nearest source of possible contamination:

1 Septic tank 2 Sewer lines 3 Watertight sewer lines 4 Lateral lines 5 Cess pool 6 Seepage pit 7 Pit privy 8 Sewage lagoon 9 Feedyard 10 Livestock pens 11 Fuel storage 12 Fertilizer storage 13 Insecticide storage 14 Abandoned water well 15 Oil well/Gas well 16 Other (specify below)

Direction from well? EAST

How many feet? 75 ft

FROM	TO	LITHOLOGIC LOG	FROM	TO	LITHOLOGIC LOG
0	2	Top Soil			
2	13	Silty Brown Clay			
13	29	Soft GRAY CLAY			
29	37	GRAY CLAY			
37	46	SANDY GRAY CLAY			
46	48	FINE SAND			
48	58	MEDIUM SAND + LOOSE LIMESTONE			
58	58 1/2	LIMESTONE			

7 CONTRACTOR'S OR LANDOWNER'S CERTIFICATION: This water well was (1) constructed, (2) reconstructed, or (3) plugged under my jurisdiction and was completed on (mo/day/year) 10-21-81 and this record is true to the best of my knowledge and belief. Kansas Water Well Contractor's License No. 138 This Water Well Record was completed on (mo/day/yr) 11-2-81 under the business name of PERSON IRRIGATION INC. by (signature) Mike Peterson

INSTRUCTIONS: Use typewriter or ball point pen, PLEASE PRESS FIRMLY and PRINT clearly. Please fill in blanks, underline or circle the correct answers. Send top three copies to Kansas Department of Health and Environment, Division of Environment, Environmental Geology Section, Topeka, KS 66620. Send one to WATER WELL OWNER and retain one for your records.

OFFICE USE ONLY T 13 R 2 END SEC. 17 SE 1/4 SE 1/4 SE 1/4