

WATER WELL RECORD Form WWC-5


Division of Water Resources App. No.

Well ID

Original Record Correction Change in Well Use

1 LOCATION OF WATER WELL: County: Dickinson Fraction SE 1/4 SW 1/4 NE 1/4 Section Number 4 Township Number T 13 S Range Number R 2 E W

2 WELL OWNER: Last Name: Sluder First: Jeremy & Allison Street or Rural Address where well is located: 2458 Haven Dr, Abilene, Ks

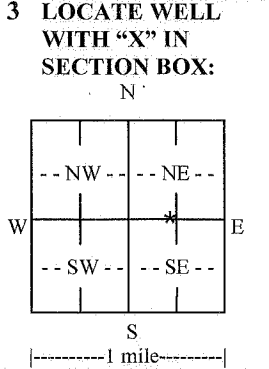

4 DEPTH OF COMPLETED WELL: 70 ft. Depth(s) Groundwater Encountered: 1) 5.2 ft. 2) ... ft. 3) ... ft. or 4) Dry Well

5 Latitude: Longitude: Datum: WGS 84 NAD 83 NAD 27 Source for Latitude/Longitude: GPS Land Survey Topographic Map Online Mapper

7 WELL WATER TO BE USED AS: 1. Domestic 2. Irrigation 3. Feedlot 4. Industrial 5. Public Water Supply 6. Dewatering 7. Aquifer Recharge 8. Monitoring 9. Environmental Remediation 10. Oil Field Water Supply 11. Test Hole 12. Geothermal 13. Other

Was a chemical/bacteriological sample submitted to KDHE? Yes No Water well disinfected? Yes No

8 TYPE OF CASING USED: Steel PVC Other CASING JOINTS: Glued Clamped Welded Threaded Casing diameter 5 in. to 7.0 ft. Casing height above land surface 1.6 in. Weight 2.00 lbs./ft. Wall thickness or gauge No. 2.50

9 GROUT MATERIAL: Neat cement Cement grout Bentonite Other Grout Intervals: From 3 ft. to 2.5 ft. Nearest source of possible contamination: Septic Tank Lateral Lines Pit Privy Livestock Pens Insecticide Storage

Table with columns: 10 FROM, TO, LITHOLOGIC LOG, FROM, TO, LITHO. LOG (cont.) or PERFORATION INTERVALS. Rows include BROWN CLAY, LITE COLOR CLAY, LITE COLOR LIMESTONE, MAROON SHALE, LITE COLOR SHALE, GRAY SHALE, LITE COLOR SHALE.

11 CONTRACTOR'S OR LANDOWNER'S CERTIFICATION: This water well was constructed, reconstructed, or plugged under my jurisdiction and was completed on (mo-day-year) 5/25/13