

WATER WELL RECORD Form WWC-5

Original Record Correction Change in Well Use


Division of Water Resources App. No.

Well ID

Well ID

1 LOCATION OF WATER WELL: County: Dickinson Fraction 1/4 NE 1/4 NE 1/4 NW 1/4 Section Number 16 Township Number T 13 S Range Number R 2 E W

2 WELL OWNER: Last Name Miller First: Matt Street or Rural Address where well is located 113 Moyne Drive Abilene, Kansas

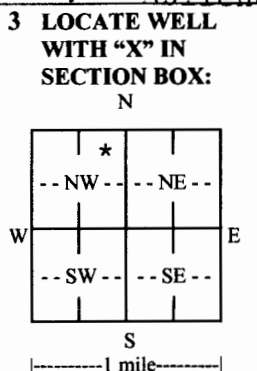

4 DEPTH OF COMPLETED WELL: 7.0 ft. Depth(s) Groundwater Encountered: 1) 4.4 ft. 2) ... ft. 3) ... ft., or 4) Dry Well

5 Latitude: ... (decimal degrees) Longitude: ... (decimal degrees) Datum: WGS 84 NAD 83 NAD 27

7 WELL WATER TO BE USED AS: 1. Domestic: Household Lawn & Garden Livestock 2. Irrigation 3. Feedlot 4. Industrial

Was a chemical/bacteriological sample submitted to KDHE? Yes No If yes, date sample was submitted: Water well disinfected? Yes No

8 TYPE OF CASING USED: Steel PVC Other CASING JOINTS: Glued Clamped Welded Threaded Casing diameter 5 in. to 7.0 ft., Diameter 1.4 in. to 1.90 lbs./ft. Wall thickness or gauge No. sch. 4.0

9 GROUT MATERIAL: Neat cement Cement grout Bentonite Other Grout Intervals: From 3 ft. to 2.5 ft., From ... ft. to ... ft., From ... ft. to ... ft.

Nearest source of possible contamination: Septic Tank Sewer Lines Watertight Sewer Lines Lateral Lines Cess Pool Seepage Pit Pit Privy Sewage Lagoon Feedyard Livestock Pens Fuel Storage Fertilizer Storage Insecticide Storage Abandoned Water Well Oil Well/Gas Well

Table with columns: FROM, TO, LITHOLOGIC LOG, FROM, TO, LITHO. LOG (cont.) & PLUGGING INTERVALS. Rows include BROWN CLAY, BROWN SAND CLAY, LITE COLOR LIMESTONE, LITE COLOR CLAY & SHALE, LITE COLOR LIMESTONE, LITE COLOR SHALE, MAROON CLAY & SHALE, LITE COLOR SHALE, LITE COLOR LIMESTONE.

11 CONTRACTOR'S OR LANDOWNER'S CERTIFICATION: This water well was constructed, reconstructed, or plugged under my jurisdiction and was completed on (mo-day-year) 3/17/15 and this record is true to the best of my knowledge and belief.