


1 LOCATION OF WATER WELL: County: Dickinson	Fraction SW ¼ SW ¼ SE ¼	Section Number 34	Township Number T 13 S	Range Number R 2 E/W
---	-----------------------------------	-----------------------------	----------------------------------	--------------------------------

Distance and direction from nearest town or city street address of well if located within city?

1038 1935 Lane, Abilene

2 WATER WELL OWNER: **Coronado Area Council**
 RR#, St. Address, Box # : **1038 1935 Lane**
 City, State, ZIP Code : **Abilene, Kansas 67410**
 Board of Agriculture, Division of Water Resources
 Application Number:

3 LOCATE WELL'S LOCATION WITH AN "X" IN SECTION BOX:

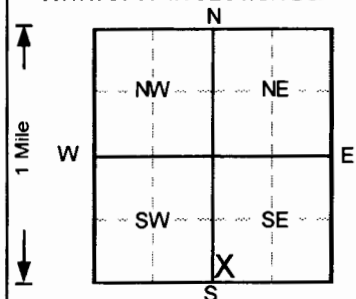

4 DEPTH OF COMPLETED WELL **77** ft. ELEVATION:
 Depth(s) Groundwater Encountered 1. ft. 2. ft. 3. ft.
 WELL'S STATIC WATER LEVEL ft. below land surface measured on mo/day/yr
 Pump test data: Well water was **NA** ft. after hours pumping gpm
 Est. Yield .. **NA** .. gpm: Well water was ft. after hours pumping gpm
 Bore Hole Diameter ... **9.5** ... in. to ... **77** ... ft. and ... in. to ... ft.
 WELL WATER TO BE USED AS: 5 Public water supply 8 Air conditioning 11 Injection well
 1 Domestic 3 Feedlot 6 Oil field water supply 9 Dewatering 12 Other (Specify below)
 2 Irrigation 4 Industrial **7** Lawn and garden only 10 Monitoring well
 Was a chemical/bacteriological sample submitted to Department? Yes.....No ; If yes, mo/day/yr sample was submitted
 Water Well Disinfected? Yes No

5 TYPE OF BLANK CASING USED: 5 Wrought iron 8 Concrete tile CASING JOINTS: Glued Clamped
 1 Steel 3 RMP (SR) 6 Asbestos-Cement 9 Other (specify below) Welded
2 PVC 4 ABS 7 Fiberglass Threaded.
 Blank casing diameter **5** in. to **47** ft. Dia in. to ft. Dia in. to ft.
 Casing height above land surface **30** in., weight lbs./ft. Wall thickness or gauge No. **Sch. 40**
 TYPE OF SCREEN OR PERFORATION MATERIAL **7** PVC 10 Asbestos-cement
 1 Steel 3 Stainless steel 5 Fiberglass **8** RMP (SR) 11 Other (specify)
 2 Brass 4 Galvanized steel 6 Concrete tile 9 ABS 12 None used (open hole)
 SCREEN OR PERFORATION OPENINGS ARE: 5 Gauzed wrapped 8 Saw cut 11 None (open hole)
 1 Continuous slot **3** Mill slot 6 Wire wrapped 9 Drilled holes
 2 Louvered shutter 4 Key punched 7 Torch cut 10 Other (specify)
 SCREEN-PERFORATED INTERVALS: From **47** ft. to **77** ft. From ft. to ft.
 GRAVEL PACK INTERVALS: From **30** ft. to **77** ft. From ft. to ft.

6 GROUT MATERIAL: 1 Neat cement 2 Cement grout **3** Bentonite 4 Other
 Grout Intervals: From **3** ft. to **30** ft. From ft. to ft. From ft. to ft.
 What is the nearest source of possible contamination:
 1 Septic tank 4 Lateral lines 7 Pit privy 10 Livestock pens 14 Abandoned water well
 2 Sewer lines 5 Cess pool 8 Sewage lagoon 11 Fuel storage 15 Oil well/Gas well
 3 Watertight sewer lines 6 Seepage pit 9 Feedyard 12 Fertilizer storage 16 Other (specify below)
 13 Insecticide storage
 Direction from well? How many feet?

FROM	TO	LITHOLOGIC LOG	FROM	TO	PLUGGING INTERVALS
0	1	Clay, Brown			
1	2	Limestone, Lt. Gray			
2	6	Clay, Yellow Brown			
6	12	Limestone, Lt. Gray to Buff			
12	19	Shale, wthrd. in part, Yellow Brown			
19	26	Shale, sl. wthrd., Gray			
26	27	Limestone, Gray			
27	28.5	Shale, sl. wthrd., Tan			
28.5	29.5	Limestone, Lt. Gray			
29.5	33	Shale, sl. wthrd., Tan			
33	46	Shale w/sl. wthrd. strngs, Red Brown			
46	56	Shale, Lt. Gray Brown to Tan			
56	60	Limestone, Lt. Gray			
60	72	Limestone, Lt. Gray and Tan			Project Name: Brown Memorial Camp
72	77	Shale, well indurated, Dark Gray			

7 CONTRACTOR'S OR LANDOWNER'S CERTIFICATION: This water well was **1** constructed, (2) reconstructed, or (3) plugged under my jurisdiction and was completed on (mo/day/year) **4/29/2016** and this record is true to the best of my knowledge and belief.
 Kansas Water Well Contractor's License No. **527** This Water Well Record was completed on (mo/day/yr) **5/10/16**
 under the business name of **GeoCore, Inc.** by (signature) *Dan Hill*