
			WWC-5			on of Water			ABMW-20	
			ge in Well Use			ces App. No		Well ID		
	KTION OF ity: Dickins	WATER WELL:	Fraction SW 1/4 NW 1/4 NE 1/2	Z. NBA/3Z.	Section	on Number 21	Township Number 13 S		nge Number PE□W	
	L OWNER		First:		r Rural		here well is located			
	s: ONE G		THSt.				itersection): If at owner	•	·	
Address	: 15 East	Fifth Street					•	-		
Address		84-4-1 OK	7D. 74400	~145 5	OI 24	v 2na 5t. 6	~99' E of S Mulb	erry St., A	bliene	
City:	<u> </u>	State: OK		-	1					
	"X" IN	4 DEPTH OF CON					e: 38.91377			
	ON BOX:	Depth(s) Groundwater								
	N			ft., or 4) Dry Well			Horizontal Datum: ☐ WGS 84 ■ NAD 83 ☐ NAD 27			
X	WELL'S STATIC WATE			measured on (mo-day-yr)			Source for Latitude/Longitude: GPS (unit make/model:)			
	NE		measured on (mo-day-yr)			(WAAS enabled? ☐ Yes ☐ No)				
		Pump test data: Well v	rater was ft.			■ Land Survey □ Topographic Map				
w	 		pumpinggpm			Online Mapper:				
SW -	SE		ater was ft. pumping gpm							
	1 1 1	Estimated Yield:	gnm gnm	gpm 6 Elevat			ո։ 1150.65 դ	. 🔳 Ground	Level TOC	
	s	Bore Hole Diameter:			- 1	Source: ■ Land Survey ☐ GPS ☐ Topographic Map				
1	mile		in. to	ft.		[Other			
7 WELL	WATER 7	TO BE USED AS:								
1. Domesti			ter Supply: well ID				ield Water Supply: le			
House		6. ☐ Dewaterin	g: how many wells?		••••		le: well ID			
☐ Lawn	& Garden	/. ☐ Aquiter Ko	echarge: well ID g: well IDABM	W-20	••••		d Uncased (
2. Irriga		o. M MODROTRI	al Remediation: well II	:::: ``	••••		mal: how many bores ed Loop Horizont			
3. Feedle		☐ Air Sparge					Loop Surface Di			
4. Indus		☐ Recovery	☐ Injection				(specify):			
Was a che	mical/hact	eriological sample subm	itted to KDHE?	Yes ■ N						
		i? 🛘 Yes 🖪 No				<i>y-2</i> , -22-2				
8 TYPE (OF CASIN	G USED: ■ Steel □ PV	C Other	CA	SING	JOINTS: [Glued Clamped	l □ Welded	Threaded	
Casing dian	neter 4	in. to24 ft., d surface0.40 in	Diameter	in. to		ft., Diamete	r in. to	ft.	_	
Casing heig	ht above lan	d surface0.40 in	. Weight	lbs./	fit.	Wall thicknes	ss or gauge NoSch.	10.SS		
1		R PERFORATION MAT					(O. 10)			
☐ Steel☐ Brass	_	ainless Steel		and (none	hala)	☐ Other	(Specify)	•••••	******	
		RATION OPENINGS AF		seu (open	noie)					
	nuous Slot		uze Wrapped 🔲 To	rch Cut [7 Drille	ed Holes	Other (Specify)			
Louve	ered Shutter	☐ Key Punched ■ Wi	ire Wrapped 🔲 Sa	w Cut [☐ None	(Open Hole)			
SCREEN-I	PERFORA?	TED INTERVALS: From	.24 ft. to .44	ft., Fro	m	ft. to	ft., From	ft. to .	ft.	
G	RAVEL PA	ACK INTERVALS: From	20 ft. to44.5	ft., Fro	m	ft. to	ft., From	ft. to .		
9 GROUT	' MATERI	AL: Neat cement D	Cement grout Be	ntonite	Other	Concrete			• • • • • • • • • • • • • • • • • • • •	
Grout Interv	als: From .		ft., From . 4	ft. to A	20	ft., From	ft. to	ft.		
Nearest sou		ble contamination: ☐ Lateral Lines	☐ Pit Privy		□ I iv	estock Pens	☐ Insectic	ida Storaga		
☐ Sewer		☐ Cess Pool	☐ Sewage Lag		_	l Storage		ned Water V	Vel1	
	ight Sewer L		☐ Feedyard			tilizer Storag				
Other (Specify) .C	ontaminated Site	-	••••			—			
10 FROM	TO	LITHOLOG	IC LOG	FROM			THO. LOG (cont.) or	PLUGGING	INTERVALS	
0	0.5	Concrete		40	44.	5 Silt	, some sand			
0.5 7	7 10	Silt, tr. clay Silt and sand		<u> </u>	-					
10	12.5	Sand, f, some silt		1	-			· ·		
12.5	16	Silt, tr. sand		<u> </u>	+				• • •	
16	20	Silt, some clay								
20	25	Clay, some silt		Notes:						
25	32	Silt, some clay		1						
32 40 Sand, f, some silt					;					
11 CONTRACTOR'S OR LANDOWNER'S CERTIFICATION: This water well was constructed, reconstructed, or plugged										
under my jurisdiction and was completed on (mo-day-year) .6/5/20.17 and this record is true to the best of my knowledge and belief.										
Kansas Water Well Contractor's License No. 527 This Water Well Record was completed on (mo-day-year) 6/14/2017										
under the business name of GeoCore Inc. Signature Signature Bureau of Water, GWTS Section, Mail 1 white copy along with a fee of \$5.00 for each constructed well to: Kansas Department of Health and Environment, Bureau of Water, GWTS Section,										
	1000 SW Jackson St., Suite 420, Topeka, Kansas 66612-1367. Mail one to Water Well Owner and retain one for your records. Telephone 785-296-5524.									
		s.gov/waterwell/index.html		SA 82a-			_ ,	Revised 7		

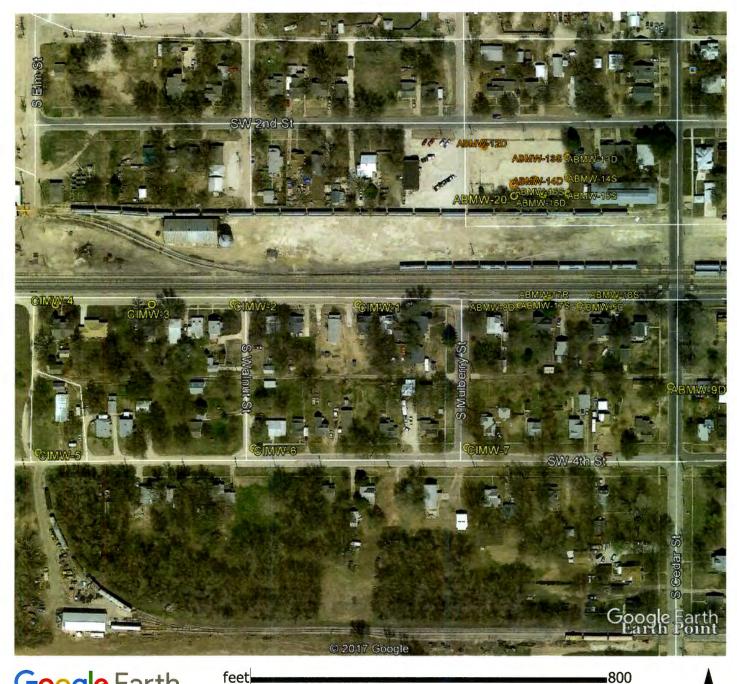

Google Earth

feet meters

200



ONE Gas (for Burns and McDonell) Abilene, Kansas

GPS Coordinates:

ABMW-5D:	38.9131138, -97.2173129	ABMV
ABMW-8D:	38.9131136, -97.2177859	ABMV
ABMW-9D:	38.9126168, -97.2165918	ABMV
ABMW-12D:	38.9140816, -97.2180669	ABMV
ABMW-12S:	38.9140928, -97.2180625	ABMV
ABMW-13D:	38.9140131, -97.2174146	ABMV
ABMW-13S:	38.9140215, -97.2174165	ABMV

W-14D: 38.9138852, -97.2174120 W-14S: 38.9138946, -97.2174112 W-15D: 38.9137872, -97.2174094 W-15S: 38.9137961, -97.2174099 W-16D: 38.9137847, -97.2175987 W-16S: 38.9137858, -97.2176098 W-17D: 38.9131615, -97.2175552

ONE Gas Abilene, Kansas Sheet 2

GPS Coordinates (cont'd):

ABMW-17S:	38.9131598, -97.2175651	CIMW-1:	38.9131215, -97.2190620
ABMW-17R:	38.9131607, -97.2175770	CIMW-2:	38.9131258, -97.2200443
ABMW-18D:	38.9131643, -97.2170046	CIMW-3:	38.9131235, -97.2206910
ABMW-18S:	38.9131589, -97.2170173	CIMW-4:	38.9131245, -97.2214561
ABMW-19:	38.9138752, -97.2176725	CIMW-5:	38.9122182, -97.2215866
ABMW-20:	38.9137790, -97.2178331	CIMW-6:	38.9122408, -97.2198854
ABMW-21:	38.9138473, -97.2178333	CIMW-7:	38.9122432, -97.2181998