
			WWC-5		Division of		1		ABMW-21	
			nge in Well Use		Resources Ap		I 1: 3: 1	Well ID	27 1	
	TION OF ty: Dickinse	WATER WELL:	Fraction SW 1/4 NW 1/4 NE 1/2		Section Nu 21	mber	Township Numb		nge Number 2 ■ E □ W	
	OWNER:		First:			ess who	ere well is located			
	S: ONE GE		A Mist.	direction fi	om nearest to	n or inte	ersection): If at owne	r's address,	check here:	
Address		Fifth Street					~100' E of S Mull			
Address		State: Of	ζ ΖΙΡ: 741 <u>03</u>	~121 3	UI 344 ZIIU	OL. G	100 E 01 3 Willi	berry Ct., i	TOTOTIC	
City: 3 LOCA	Tulsa			4.4			20.04004			
WITH		4 DEPTH OF CO	MPLETED WELL:	44			. 38.91384			
	ON BOX:		r Encountered: 1)							
	N						oniai Datum: WGS 64 NAD 65 NAD 27			
IX			e, measured on (mo-day	/-yr) GPS (unit make/model:)			
NW -	NE		measured on (mo-day-yr)			(WAAS enabled? ☐ Yes ☐ No)				
1 1 1							Land Survey Topographic Map			
W	E	1	rs pumping							
sw	SE		rs pumping							
		Estimated Vield	gnm		6 EJ	evation	1: 115U.29 A	. Ground	I Level ☐ TOC	
	S	Bore Hole Diameter:	11 in. to 44.5	ft. and	<u>Sc</u>		Land Survey 🔲 (
<u> </u>			in. to	ft.			Outer		*******************	
7 WELL 1. Domestic		O BE USED AS:	/ater Supply: well ID		10 [] Oil Fiz	eld Water Supply: le	ease		
1. Domestic			ing: how many wells?				: well ID			
	& Garden	7. \square Aquifer l	Recharge: well ID				☐ Uncased ☐ €			
Livest	tock	8. 🔳 Monitori	ng: well IDABM	IW-21	12. G		al: how many bores			
2. 🔲 Irrigat			ital Remediation: well I				Loop Horizont			
3. Feedle		☐ Air Spar		Extraction			Loop Surface Dis (specify):			
4. Indust		Recovery								
		eriological sample sub	mitted to KDHE? □	Yes N	lo If yes,	date sar	nple was submitte	a:	••••••	
		? Yes No	VO E 04	CA	CINIC IOIN	Tre.	Class Comment	1 D 37/21d2	Throaded	
8 TYPE C	JF CASING	G USED: ■ Steel □ PV	VU Uther	in to	AIOL DAIG. A B	IIS: ∐ Biameter	Glued Clamped	. □ welder	i m i meaded	
Casing heig	ht above land	in to 24 ft surface -0.52 i	in. Weight	lbs./	ft. Wall t	hickness	or gauge No. Sch.	. 10 SS		
TYPE OF	SCREEN O	R PERFORATION MA	ATERIAL:				2 2			
☐ Steel	📕 Sta	inless Steel	erglass PVC			Other (S	Specify)			
☐ Brass				ised (open l	nole)					
		RATION OPENINGS A			7 15-211- 2 77-		Oth (S:E-)			
☐ Conti	nuous Slot	☐ Mill Slot ☐ C☐ Key Punched ☐ V			None (Ope		Other (Specify)		**********	
SCREEN-I	PERFORAT	ED INTERVALS: From	m 24 ft to 44	ft From	m 1	t. to	ft From	ft. to	ft.	
l G	RAVEL PA	CK INTERVALS: From	m 20 ft. to .44.	ft Fro	m 1	t. to	ft., From	ft. to	ft.	
9 GROUT	MATERI	AL: Neat cement	Cement grout Be	ntonite	Other Co	ncrete				
Grout Interv	als: From		ft., From . 2	ft. to 2	9 ft., Fr	om	ft. to	ft.		
		le contamination:	—			_		11 6.		
☐ Septic		☐ Lateral Lin ☐ Cess Pool	es ☐ Pit Privy ☐ Sewage La		☐ Livestock☐ Fuel Stora			ide Storage med Water V	17.11	
Sewer	Lines ight Sewer L				☐ Fuel Stor				y CH	
Other	Specify)					G.0				
Direction fro	om well?		Distance from w	eli?						
10 FROM	TO	LITHOLO	GIC LOG	FROM	ТО	LIT	HO. LOG (cont.) or	PLUGGING	3 INTERVALS	
0	0.25	Concrete	<u> </u>							
0.25		Sand, f, tr. silt								
1	7.5	Clay, some silt		-		-				
7.5		Sand, f		+	-					
12		Sand, f, some silt		+		-				
17.5		Silt, some clay		Notes:	1					
35		Silt, some sand Sand, f, some silt		- 140res:						
40 Sand, f, some slit. 40 44.5 Sand, f-m, some silt, tr. gravel										
11 CONTRACTOR'S OR LANDOWNER'S CERTIFICATION: This water well was a constructed. reconstructed or plugged										
under my jurisdiction and was completed on (mo-day-year) .6/5/20.17 and this record is true to the best of my knowledge and belief.										
Kansas Water Well Contractor's License No. 527 This Water Well Record was completed on (mg-day-year) 6/14/2017										
Mail 1 white copy along with a fee of \$5.00 for each constructed well to: Kansas Department of Health and Environment, Bureau of Water, GWTS Section,										
	1000 SW Jackson St., Suite 420, Topeka, Kansas 66612-1367. Mail one to Water Well Owner and retain one for your records. Telephone 785-296-5524.									
		s.gov/waterwell/index.html		KSA 82a-				Revised	7/10/2015	

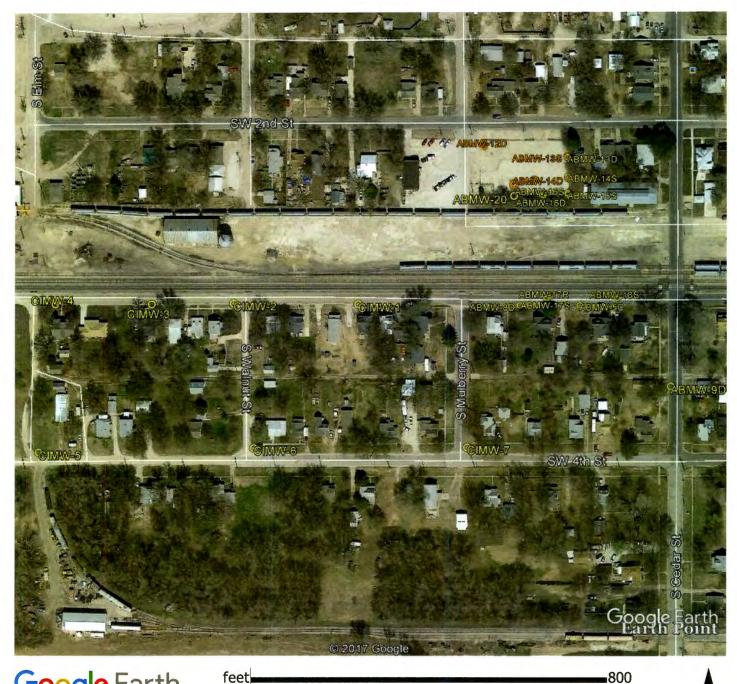

Google Earth

feet meters

200



ONE Gas (for Burns and McDonell) Abilene, Kansas

GPS Coordinates:

ABMW-5D:	38.9131138, -97.2173129	ABMV
ABMW-8D:	38.9131136, -97.2177859	ABMV
ABMW-9D:	38.9126168, -97.2165918	ABMV
ABMW-12D:	38.9140816, -97.2180669	ABMV
ABMW-12S:	38.9140928, -97.2180625	ABMV
ABMW-13D:	38.9140131, -97.2174146	ABMV
ABMW-13S:	38.9140215, -97.2174165	ABMV

W-14D: 38.9138852, -97.2174120 W-14S: 38.9138946, -97.2174112 W-15D: 38.9137872, -97.2174094 W-15S: 38.9137961, -97.2174099 W-16D: 38.9137847, -97.2175987 W-16S: 38.9137858, -97.2176098 W-17D: 38.9131615, -97.2175552

ONE Gas Abilene, Kansas Sheet 2

GPS Coordinates (cont'd):

ABMW-17S:	38.9131598, -97.2175651	CIMW-1:	38.9131215, -97.2190620
ABMW-17R:	38.9131607, -97.2175770	CIMW-2:	38.9131258, -97.2200443
ABMW-18D:	38.9131643, -97.2170046	CIMW-3:	38.9131235, -97.2206910
ABMW-18S:	38.9131589, -97.2170173	CIMW-4:	38.9131245, -97.2214561
ABMW-19:	38.9138752, -97.2176725	CIMW-5:	38.9122182, -97.2215866
ABMW-20:	38.9137790, -97.2178331	CIMW-6:	38.9122408, -97.2198854
ABMW-21:	38.9138473, -97.2178333	CIMW-7:	38.9122432, -97.2181998