
WATER WELL RECORD Form WWC-5					Division of Water			ABMW-9D		
Original Record Correction Change in Well Use 1 LOCATION OF WATER WELL: Fraction				Resources App. No. Section Number		Ø 1: N 1	Well ID	Range Number		
			Fraction		ection Number 21	per	Township Number T 13 S		ige Number □ ■ E □ W	
	ty: Dickins		NE ¼ SW ¼ NE ½							
2 WELL OWNER: Last Name: First: Street or Rural Address where well is loc direction from nearest town or intersection): If at						•	_			
Address		Fifth Street					,			
Address		i ilui olieet		~175' S of	f SW come	r of S	W 3rd & S Ceda	r Sts., Abi	ilene	
City:	Tulsa	State: OK	ZIP: 74103							
3 LOCAT		A DEPTH OF COM		13	A 5 7 .:		38 012616	38		
WITH	WITH "X" IN SECTION POY. 4 DEPTH OF COMPLETED WELL: Depth(s) Groundwater Encountered: 1)									
	ON BOX:		3) ft., or 4) [
	N							III NAD	33 LI NAD 27	
WELL'S STATIC WATER LEVEL: □ below land surface, measured on				Source to Laurude, Longitude.			,			
				measured on (mo-day-yr)			(WAAS enabled? ☐ Yes ☐ No)			
	7-72-1	Pump test data: Well w			■ Land Survey ☐ Topographic Map					
l w	╎ ┼┤╒	after hours	pumping	gpm						
677/	5		ater was f							
sw	- SE		pumping	gpm	6 Flow	ation	. 1147.98 n	Cround	Level D TOC	
	للليا	Estimated Yield:	gpm	0 . 1	South	ce.	Land Survey G		nographic Man	
	S mile	Bore Hole Diameter:	9.9 in. to	It. and	3000		Other		. ~ .	
			in. to							
1. Domestic		O BE USED AS:	ter Supply: well ID		10 🗆 0	il Fiai	ld Water Supply: lea	200		
Domestic			g: how many wells?				well ID			
_	& Garden		charge: well ID				☐ Uncased ☐ G			
Livest		8. Monitoring	g: well ID ABM	№-9D	. 12. Geot		al: how many bores?			
2. Irrigat			l Remediation: well ID							
3. Feedle		☐ Air Sparge	☐ Soil Vapor I		b) C		oop 🔲 Surface Dis			
4. 🔲 Indust	trial	☐ Recovery	☐ Injection		13. 🔲 0	ther (specify):			
Was a che	mical/bact	eriological sample submi	itted to KDHE?	Yes No	If yes, dat	e sam	ple was submitted	:		
		? ☐ Yes ■ No			,		A			
8 TYPE (OF CASING	G USED: □ Steel ■ PV(C Other	CAS	ING JOINTS	S: 🗖	Glued Clamped	□ Welded	■ Threaded	
Casing diam	neter2	G USED: ☐ Steel ■ PVC in. to32.5 ft.,	Diameter2	in. to4	3 ft Diar	neter .	in. to	ft.		
Casing heig	ht above land	surface -0.45 in.	Weight	lbs./ft.	Wall thic	kness	or gauge No. Sch.	40		
		R PERFORATION MAT								
☐ Steel	☐ Sta	inless Steel	glass PVC		□ Ot	her (S	pecify)			
☐ Brass		Ivanized Steel		sed (open ho	le)					
		RATION OPENINGS AR		_		_				
	nuous Slot	■ Mill Slot □ Gar	uze Wrapped	rch Cut 🔲	Drilled Holes	\Box	Other (Specify)	• • • • • • • • • • • • • • • • • • • •		
Louve	ered Shutter	☐ Key Punched ☐ Wi	re Wrapped ∐ Sav	v Cut 🔲	None (Open I	lole)		•		
		ED INTERVALS: From								
		CK INTERVALS: From								
9 GROUI	MATERI	AL: Neat cement	Cement grout Ber	ntonite E	Other Suice	iere				
Grout Interv	als: From	0 ft. to 1.5	ft., From 1	t. to	2 ft., From	•••••	It. to	Ħ.		
Nearest sou		le contamination:	☐ Pit Privy	_	Livestock Pe	ne	☐ Insectici	le Storage		
☐ Sewer		☐ Cess Pool	☐ Sewage Lag		Fuel Storage			-	/ell	
	ight Sewer L		☐ Feedyard		Fertilizer Sto		☐ Oil Well		-	
	Other (Specify) .Contaminated Site									
Direction fro	om well?			11?						
10 FROM	TO	LITHOLOG	IC LOG	FROM	TO	LITH	IO. LOG (cont.) or P	LUGGING	INTERVALS	
0	0.25	Asphalt								
0.25	0.5	Gravel and f sand								
0.5	8	Clay, some silt								
8	16	Silt, some clay		-	1					
16	25	Clay and silt								
25		Silt, some clay								
30		Sand and silt, tr. clay		Notes:						
35		Sand, tr. silt and gravel								
11 CONTRACTOR'S OR LANDOWNER'S CERTIFICATION: This water well was constructed, reconstructed, or plugged										
under my jurisdiction and was completed on (mo-day-year) .6/5/17										
Kansas Wa	ter Well Co	ntractor's License No24		er Well Re	cord was con	nplete	edon (mapo-dayAyea	r) .6/.14/2!	λλ	
under the business name of GeoCore Inc. Mail 1 white copy along with a fee of \$5.00 for each constructed well to: Kansas Department of Health and Environment, Bureau of Water, GWTS Section,										
Mail I white copy along with a fee of \$5.00 for each constructed well to: Kansas Department of Health and Environment, Bureau of Water, GW18 Section, 1000 SW Jackson St., Suite 420, Topeka, Kansas 66612-1367. Mail one to Water Well Owner and retain one for your records. Telephone 785-296-5524.										
		t., Suite 420, Topeka, Kansas 66 s.gov/waterwell/index.html		SA 82a-12		ne for y	your records. Letephon	Revised 7		
VISIL US AL TILLD	<u>,,,, www.kanek</u>	S. KOV WAICH WEIL HIUCX, HIIII	<u></u>	NOTE 040-14	- 1.2			ARETISCU /	LIVAUL	

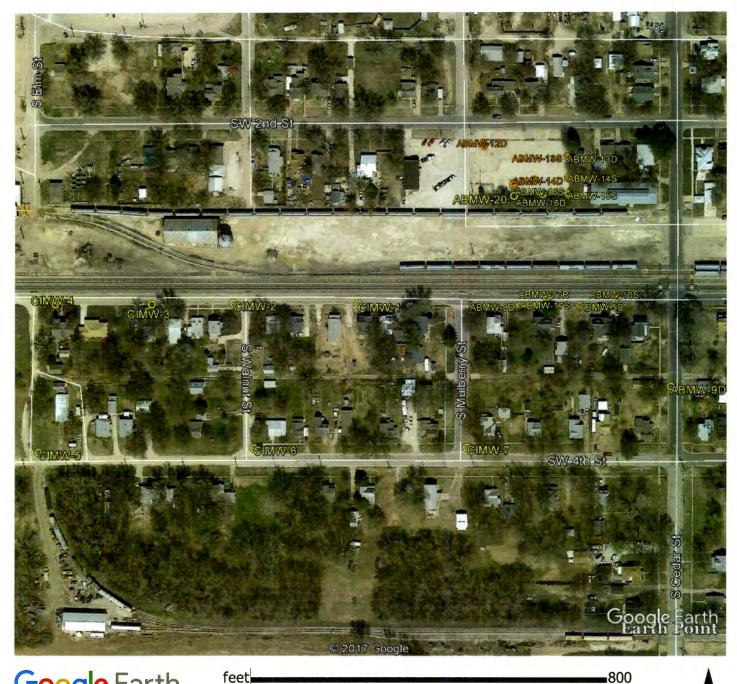

Google Earth

feet meters

200



ONE Gas (for Burns and McDonell) Abilene, Kansas

GPS Coordinates:

ABMW-5D:	38.9131138, -97.2173129	ABMV
ABMW-8D:	38.9131136, -97.2177859	ABMV
ABMW-9D:	38.9126168, -97.2165918	ABMV
ABMW-12D:	38.9140816, -97.2180669	ABMV
ABMW-12S:	38.9140928, -97.2180625	ABMV
ABMW-13D:	38.9140131, -97.2174146	ABMV
ABMW-13S:	38.9140215, -97.2174165	ABMV

W-14D: 38.9138852, -97.2174120 W-14S: 38.9138946, -97.2174112 W-15D: 38.9137872, -97.2174094 W-15S: 38.9137961, -97.2174099 W-16D: 38.9137847, -97.2175987 W-16S: 38.9137858, -97.2176098 W-17D: 38.9131615, -97.2175552

ONE Gas Abilene, Kansas Sheet 2

GPS Coordinates (cont'd):

ABMW-17S:	38.9131598, -97.2175651	CIMW-1:	38.9131215, -97.2190620
ABMW-17R:	38.9131607, -97.2175770	CIMW-2:	38.9131258, -97.2200443
ABMW-18D:	38.9131643, -97.2170046	CIMW-3:	38.9131235, -97.2206910
ABMW-18S:	38.9131589, -97.2170173	CIMW-4:	38.9131245, -97.2214561
ABMW-19:	38.9138752, -97.2176725	CIMW-5:	38.9122182, -97.2215866
ABMW-20:	38.9137790, -97.2178331	CIMW-6:	38.9122408, -97.2198854
ABMW-21:	38.9138473, -97.2178333	CIMW-7:	38.9122432, -97.2181998