

**WATER WELL PLUGGING RECORD Form WWC-5P**

**KSA 82a-1212 ID NO.** IRM Well

<b>1 LOCATION OF WATER WELL:</b> County: <u>Dickinson</u>	Fraction <u>SE 1/4 NW 1/4 NE 1/4 NE 1/4</u>	Section Number <u>20</u>	Township Number <u>13 S</u>	Range Number <u>2</u> <input checked="" type="checkbox"/> E <input type="checkbox"/> W
--	--	-----------------------------	--------------------------------	---

Street/Rural Address of Well Location; if unknown, distance and direction from nearest town or intersection. If at owner's address, check here


.1200' SW of intersection of W 1st & Cherry, Abilene

**Global Positioning Systems (GPS) Information:**

Latitude: 38.91348 (in decimal degrees)  
 Longitude: -97.22801 (in decimal degrees)  
 Elevation: \_\_\_\_\_  
 Datum:  WGS84  NAD83  NAD27

Collection Method:  
 GPS unit Make/Model: \_\_\_\_\_  
 Digital Map/Photo  Topographic Map  Land Survey  
 Est. Accuracy:  <3 m  3-5 m  5-15 m  >15 m

**2 WATER WELL OWNER:** GPI Interim Inc.  
 RR#, St. Address, Box # 33 Commercial St.  
 City, State ZIP Code Foxboro, MA 02035

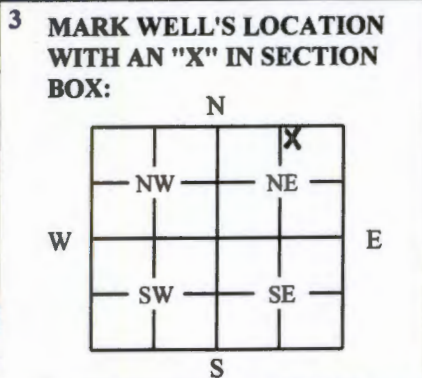

**4 DEPTH OF WELL:** 51.4 ft.  
**WELL'S STATIC WATER LEVEL:** 15.2 ft.  
**WELL WAS USED AS:**

<input type="checkbox"/> Domestic	<input type="checkbox"/> Public Water Supply	<input checked="" type="checkbox"/> Dewatering
<input type="checkbox"/> Irrigation	<input type="checkbox"/> Old Field Water Supply	<input type="checkbox"/> Monitoring
<input type="checkbox"/> Feedlot	<input type="checkbox"/> Domestic (Lawn/Garden)	<input type="checkbox"/> Injection Well
<input type="checkbox"/> Industrial	<input type="checkbox"/> Air Conditioning	<input type="checkbox"/> Other _____

Was a chemical/bacteriological sample submitted to Department?  Yes  No

**5 TYPE OF BLANK CASING USED:**

<input checked="" type="checkbox"/> Steel	<input type="checkbox"/> RMP (SR)	<input type="checkbox"/> Wrought	<input type="checkbox"/> Fiberglass	<input type="checkbox"/> Other: _____
<input type="checkbox"/> PVC	<input type="checkbox"/> ABS	<input type="checkbox"/> Asbestos/Cement	<input type="checkbox"/> Concrete Tile	

Blank casing diameter: 10 in. Was casing pulled?  Yes  No If Yes, how much 4'  
 Casing height above or below land surface: \_\_\_\_\_ in.

**6 GROUT PLUG MATERIAL:**  Neat cement  Cement grout  Bentonite  Other: \_\_\_\_\_

Grout Plug Intervals: From 3 ft. To 22 ft. From \_\_\_\_\_ ft. To \_\_\_\_\_ ft. From \_\_\_\_\_ ft. To \_\_\_\_\_ ft.

What is the nearest source of possible contamination:

<input type="checkbox"/> Septic tank	<input type="checkbox"/> Seepage pit	<input type="checkbox"/> Fuel storage	<input type="checkbox"/> Other (specify below): _____
<input type="checkbox"/> Sewer lines	<input type="checkbox"/> Pit privy	<input type="checkbox"/> Fertilizer storage	
<input type="checkbox"/> Watertight sewer lines	<input type="checkbox"/> Sewage lagoon	<input type="checkbox"/> Insecticide storage	
<input type="checkbox"/> Lateral lines	<input type="checkbox"/> Feedyard	<input type="checkbox"/> Abandoned water well	Direction from well: _____
<input type="checkbox"/> Cess pool	<input type="checkbox"/> Livestock pens	<input type="checkbox"/> Oil well/Gas well	How many feet: _____

FROM	TO	PLUGGING MATERIAL	FROM	TO	PLUGGING MATERIAL
0	3	Native soil			
3	22	Bentonite			
22	51.4	Sand Chlorinated			IRM Well

**7 CONTRACTOR'S OR LANDOWNER'S CERTIFICATION:** This water well was plugged under my jurisdiction and was completed on (mo/day/year) 6/2/2017 and this record is true to the best of my knowledge and belief. Kansas Water Well Contractor's License No. 527. This Water Well Record was completed on (mo/day/year) 6/21/2017 under the business name of GeoCore Inc. by (signature) [Signature]

**INSTRUCTIONS:** Use typewriter or ballpoint pen. Please press firmly and print clearly. Please fill in blanks, underline or circle the correct answers. Send one copy to Kansas Department of Health and Environment, Bureau of Water, Geology Section, 1000 SW Jackson St., Ste. 420, Topeka, Kansas 66612-1367. Telephone 785/296-5524. Send one to Water Well Owner and retain one for your records. Visit us at <http://www.kdheks.gov/waterwell/index.html>.



Google Earth



GPI Interim Site, formerly Vacublast (for GeoSyntec)  
Abilene, Kansas

GPS Coordinates:

IRM Well: 38.91348, -97.22801  
 KDHE MW-1: 38.91886, -97.23605  
 KDHE MW-3: 38.92242, -97.23135  
 MW-8: 38.92384, -97.23456  
 MW-9: 38.92384, -97.23454  
 MW-10: 38.92284, -97.23378  
 MW-11: 38.92284, -97.23367  
 MW-18: 38.92056, -97.23392

MW-21: 38.92006, -97.23402  
 MW-22: 38.91990, -97.23294  
 MW-23: 38.92058, -97.23049  
 MW-27: 38.91863, -97.23015  
 MW-28: 38.91863, -97.23001  
 MW-29: 38.91632, -97.23053  
 MW-30: 38.91632, -97.23039  
 MW-31: 38.91540, -97.22569

GPI Interim Site, formerly Vacublast (for GeoSyntec)  
Abilene, Kansas  
Sheet 2

GPS Coordinates (cont'd):

MW-33: 38.91370, -97.22780  
MW-34: 38.91118, -97.22841  
MW-40: 38.91516, -97.23303  
MW-41: 38.91232, -97.22749  
MW-60: 38.91545, -97.22563  
MW-71: 38.91529, -97.22939

MW-33BR: 38.91385, -97.22790  
MW-39: 38.91516, -97.23289  
MW-40: 38.91516, -97.23303  
MW-42: 38.91233, -97.22732  
MW-61: 38.91278, -97.22489  
MW-72: 38.91537, -97.23044