

WATER WELL PLUGGING RECORD Form WWC-5P

KSA 82a-1212 ID NO. KDHE MW-3

1 LOCATION OF WATER WELL: County: <u>Dickinson</u>	Fraction <u>NE 1/4 NW 1/4 NW 1/4 SE 1/4</u>	Section Number <u>17</u>	Township Number <u>13 S</u>	Range Number <u>2</u> <input checked="" type="checkbox"/> E <input type="checkbox"/> W
--	--	-----------------------------	--------------------------------	---

Street/Rural Address of Well Location; if unknown, distance and direction from nearest town or intersection. If at owner's address, check here


380' E & 12' S of 8th & Washington, Abilene

Global Positioning Systems (GPS) Information:

Latitude: 38.92242 (in decimal degrees)
 Longitude: -97.23135 (in decimal degrees)
 Elevation: _____
 Datum: WGS84 NAD83 NAD27
 Collection Method:
 GPS unit Make/Model: _____
 Digital Map/Photo Topographic Map Land Survey
 Est. Accuracy: <3 m 3-5 m 5-15 m >15 m

2 WATER WELL OWNER: GPI Interim Inc.
 RR#, St. Address, Box # 33 Commercial St.
 City, State ZIP Code Foxboro, MA 02035

3 MARK WELL'S LOCATION WITH AN "X" IN SECTION BOX:

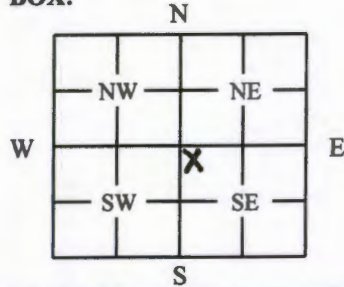

4 DEPTH OF WELL: 38.5 ft.
WELL'S STATIC WATER LEVEL: 7.6 (bgs) ft.
WELL WAS USED AS:

- Domestic
- Irrigation
- Feedlot
- Industrial
- Public Water Supply
- Old Field Water Supply
- Domestic (Lawn/Garden)
- Air Conditioning
- Dewatering
- Monitoring
- Injection Well
- Other _____

Was a chemical/bacteriological sample submitted to Department? Yes No

5 TYPE OF BLANK CASING USED:

Steel RMP (SR) Wrought Fiberglass Other: _____
 PVC ABS Asbestos/Cement Concrete Tile _____
 Blank casing diameter: 2 in. Was casing pulled? Yes No If Yes, how much 3'
 Casing height above or below land surface: 1.8' in.

6 GROUT PLUG MATERIAL: Neat cement Cement grout Bentonite Other: _____

Grout Plug Intervals: From 3 ft. To 21 ft. From _____ ft. To _____ ft. From _____ ft. To _____ ft.

What is the nearest source of possible contamination:

- Septic tank
- Sewer lines
- Watertight sewer lines
- Lateral lines
- Cess pool
- Seepage pit
- Pit privy
- Sewage lagoon
- Feedyard
- Livestock pens
- Fuel storage
- Fertilizer storage
- Insecticide storage
- Abandoned water well
- Oil well/Gas well
- Other (specify below): _____

Direction from well: _____
 How many feet: _____

FROM	TO	PLUGGING MATERIAL	FROM	TO	PLUGGING MATERIAL
0	3	Native soil			
3	21	Bentonite			
21	38.5	Sand Chlorinated			KDHE MW-3

7 CONTRACTOR'S OR LANDOWNER'S CERTIFICATION: This water well was plugged under my jurisdiction and was completed on (mo/day/year) 6/6/2017 and this record is true to the best of my knowledge and belief. Kansas Water Well Contractor's License No. 527. This Water Well Record was completed on (mo/day/year) 6/21/2017 under the business name of GeoCore Inc. by (signature) [Signature]

INSTRUCTIONS: Use typewriter or ballpoint pen. Please press firmly and print clearly. Please fill in blanks, underline or circle the correct answers. Send one copy to Kansas Department of Health and Environment, Bureau of Water, Geology Section, 1000 SW Jackson St., Ste. 420, Topeka, Kansas 66612-1367. Telephone 785/296-5524. Send one to Water Well Owner and retain one for your records. Visit us at <http://www.kdheks.gov/waterwell/index.html>.





