


WATER WELL RECORD Form WWC-5

Original Record Correction Change in Well Use

Division of Water Resources App. No. Well ID

1 LOCATION OF WATER WELL: County: Dickinson Fraction 1/4 SE 1/4 NE 1/4 SE 1/4 Section Number 4 Township Number T 13 S Range Number R 2 E W W

2 WELL OWNER: Last Name: Sare First: Tim Street or Rural Address where well is located (if unknown, distance and direction from nearest town or intersection): If at owner's address, check here:
 Business: Address: 500 N Kuney City: Abilene State: Ks ZIP: 67410
2431 Hawk Rd Abilene, Kansas

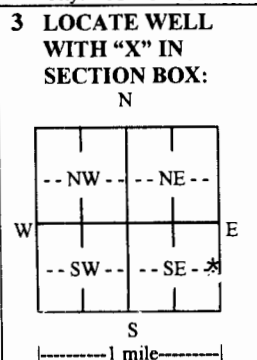

4 DEPTH OF COMPLETED WELL: 90 ft.
 Depth(s) Groundwater Encountered: 1) 56 ft.
 2) ft. 3) ft., or 4) Dry Well
 WELL'S STATIC WATER LEVEL: 50 ft.
 below land surface, measured on (mo-day-yr) 9/7/17.
 above land surface, measured on (mo-day-yr)
 Pump test data: Well water was ft.
 after hours pumping gpm
 Well water was ft.
 after hours pumping gpm
 Estimated Yield: 7-8 gpm
 Bore Hole Diameter: 9 in. to 9.0 ft. and
 in. to ft.

5 Latitude: (decimal degrees)
Longitude: (decimal degrees)
 Horizontal Datum: WGS 84 NAD 83 NAD 27
 Source for Latitude/Longitude:
 GPS (unit make/model:)
 (WAAS enabled? Yes No)
 Land Survey Topographic Map
 Online Mapper:
6 Elevation: ft. Ground Level TOC
 Source: Land Survey GPS Topographic Map
 Other

7 WELL WATER TO BE USED AS:

I. Domestic: Household Lawn & Garden Livestock
 2. Irrigation 3. Feedlot 4. Industrial
 5. Public Water Supply: well ID
 6. Dewatering: how many wells?
 7. Aquifer Recharge: well ID
 8. Monitoring: well ID
 9. Environmental Remediation: well ID
 Air Sparge Soil Vapor Extraction
 Recovery Injection
 10. Oil Field Water Supply: lease
 11. Test Hole: well ID
 Cased Uncased Geotechnical
 12. Geothermal: how many bores?
 a) Closed Loop Horizontal Vertical
 b) Open Loop Surface Discharge Inj. of Water
 13. Other (specify):

Was a chemical/bacteriological sample submitted to KDHE? Yes No If yes, date sample was submitted:
 Water well disinfected? Yes No

8 TYPE OF CASING USED: Steel PVC Other CASING JOINTS: Glued Clamped Welded Threaded
 Casing diameter 5 in. to 9.0 ft., Diameter in. to ft., Diameter in. to ft.
 Casing height above land surface 14 in. Weight 200 lbs./ft. Wall thickness or gauge No. ... 250
 TYPE OF SCREEN OR PERFORATION MATERIAL:
 Steel Stainless Steel Fiberglass PVC Other (Specify)
 Brass Galvanized Steel Concrete tile None used (open hole)
 SCREEN OR PERFORATION OPENINGS ARE:
 Continuous Slot Mill Slot Gauze Wrapped Torch Cut Drilled Holes Other (Specify)
 Louvered Shutter Key Punched Wire Wrapped Saw Cut None (Open Hole)
 SCREEN-PERFORATED INTERVALS: From 5.0 ft. to 7.0 ft., From ft. to ft., From ft. to ft.
 GRAVEL PACK INTERVALS: From 2.4 ft. to 9.0 ft., From ft. to ft., From ft. to ft.

9 GROUT MATERIAL: Neat cement Cement grout Bentonite Other
 Grout Intervals: From 0 ft. to 2.4 ft., From ft. to ft., From ft. to ft.
 Nearest source of possible contamination:
 Septic Tank Lateral Lines Pit Privy Livestock Pens Insecticide Storage
 Sewer Lines Cess Pool Sewage Lagoon Fuel Storage Abandoned Water Well
 Watertight Sewer Lines Seepage Pit Feedyard Fertilizer Storage Oil Well/Gas Well
 Other (Specify)
 Direction from well? SOUTHWEST Distance from well? APPROX 300 ft.

10 FROM	TO	LITHOLOGIC LOG	FROM	TO	LITHO. LOG (cont.) or PLUGGING INTERVALS
	!	BROWN CLAY	53	56	LITE COLOR SHALE
1	3	lite gray shale	56	70	GRAY SHALE
3	4	LIMESTONE	70	84	MAROON SHALE
4	15	LITE COLOR SHALE & CLAY	84	90	LITE COLOR SHALE
15	19	DARK MAROON SHALE			
19	25	GRAY & LITE COLOR SHALE			
25	32	MAROON SHALE & CLAY			
32	47	LITE COLOR SHALE & CLAY			
47	53	VERY HARD LIMESTONE & FLINT			

11 CONTRACTOR'S OR LANDOWNER'S CERTIFICATION: This water well was constructed, reconstructed, or plugged under my jurisdiction and was completed on (mo-day-year) 9/7/17 and this record is true to the best of my knowledge and belief. Kansas Water Well Contractor's License No. 397 This Water Well Record was completed on (mo-day-year) 9/14/17 under the business name of CENTRAL KANSAS DRILLING Signature