


WATER WELL PLUGGING RECORD Form WWC-5P

KSA 82a-1212 ID NO. MW-39

1 LOCATION OF WATER WELL: County: Dickinson	Fraction NE 1/4 NE 1/4 NE 1/4 NW 1/4	Section Number 20	Township Number 13 S	Range Number 2 <input checked="" type="checkbox"/> E <input type="checkbox"/> W
--	--	-----------------------------	--------------------------------	---

Street/Rural Address of Well Location; if unknown, distance and direction from nearest town or intersection. If at owner's address, check here <input type="checkbox"/> 55' W & 12' S of 1st & Washington, Abilene	Global Positioning Systems (GPS) Information: ^{DELL} Latitude: 38.91516 (in decimal degrees) Longitude: -97.23289 (in decimal degrees) Elevation: _____ Datum: <input checked="" type="checkbox"/> WGS84 <input type="checkbox"/> NAD83 <input type="checkbox"/> NAD27 Collection Method: <input type="checkbox"/> GPS unit Make/Model: _____ <input type="checkbox"/> Digital Map/Photo <input type="checkbox"/> Topographic Map <input checked="" type="checkbox"/> Land Survey Est. Accuracy: <input checked="" type="checkbox"/> <3 m <input type="checkbox"/> 3-5 m <input type="checkbox"/> 5-15 m <input type="checkbox"/> >15 m
--	---

2 WATER WELL OWNER: GPI Interim Inc. RR#, St. Address, Box # 33 Commercial St. City, State ZIP Code Foxboro, MA 02035	
--	--

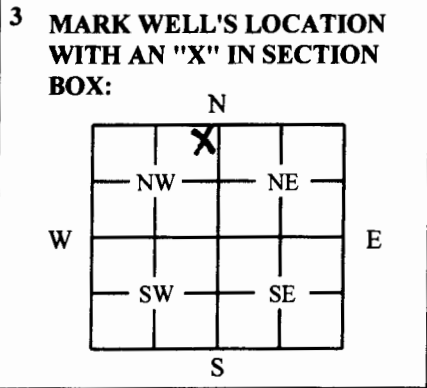

4 DEPTH OF WELL: 49.36 ft.
WELL'S STATIC WATER LEVEL: 14.57 ft.
WELL WAS USED AS:

<input type="checkbox"/> Domestic	<input type="checkbox"/> Public Water Supply	<input type="checkbox"/> Dewatering
<input type="checkbox"/> Irrigation	<input type="checkbox"/> Old Field Water Supply	<input checked="" type="checkbox"/> Monitoring
<input type="checkbox"/> Feedlot	<input type="checkbox"/> Domestic (Lawn/Garden)	<input type="checkbox"/> Injection Well
<input type="checkbox"/> Industrial	<input type="checkbox"/> Air Conditioning	<input type="checkbox"/> Other _____

Was a chemical/bacteriological sample submitted to Department? Yes No

5 TYPE OF BLANK CASING USED:

<input type="checkbox"/> Steel	<input type="checkbox"/> RMP (SR)	<input type="checkbox"/> Wrought	<input type="checkbox"/> Fiberglass	<input type="checkbox"/> Other: _____
<input checked="" type="checkbox"/> PVC	<input type="checkbox"/> ABS	<input type="checkbox"/> Asbestos/Cement	<input type="checkbox"/> Concrete Tile	

Blank casing diameter: 2 in. Was casing pulled? Yes No If Yes, how much 3'
 Casing height above or below land surface: 0 in.

6 GROUT PLUG MATERIAL: Neat cement Cement grout Bentonite Other: _____

Grout Plug Intervals: From 3 ft. To 21 ft. From _____ ft. To _____ ft. From _____ ft. To _____ ft.

What is the nearest source of possible contamination:

<input type="checkbox"/> Septic tank	<input type="checkbox"/> Seepage pit	<input type="checkbox"/> Fuel storage	<input type="checkbox"/> Other (specify below): _____
<input type="checkbox"/> Sewer lines	<input type="checkbox"/> Pit privy	<input type="checkbox"/> Fertilizer storage	
<input type="checkbox"/> Watertight sewer lines	<input type="checkbox"/> Sewage lagoon	<input type="checkbox"/> Insecticide storage	
<input type="checkbox"/> Lateral lines	<input type="checkbox"/> Feedyard	<input type="checkbox"/> Abandoned water well	Direction from well: _____
<input type="checkbox"/> Cess pool	<input type="checkbox"/> Livestock pens	<input type="checkbox"/> Oil well/Gas well	How many feet: _____

FROM	TO	PLUGGING MATERIAL	FROM	TO	PLUGGING MATERIAL
0	3	Native soil			
3	21	Bentonite			
21	49.36	Sand Chlorinated			MW-39

7 CONTRACTOR'S OR LANDOWNER'S CERTIFICATION: This water well was plugged under my jurisdiction and was completed on (mo/day/year) 6/7/2017 and this record is true to the best of my knowledge and belief. Kansas Water Well Contractor's License No. 527. This Water Well Record was completed on (mo/day/year) 6/21/2017 under the business name of GeoCore Inc. by (signature) [Signature]

INSTRUCTIONS: Use typewriter or ballpoint pen. Please press firmly and print clearly. Please fill in blanks, underline or circle the correct answers. Send one copy to Kansas Department of Health and Environment, Bureau of Water, Geology Section, 1000 SW Jackson St., Ste. 420, Topeka, Kansas 66612-1367. Telephone 785/296-5524. Send one to Water Well Owner and retain one for your records. Visit us at <http://www.kdheks.gov/waterwell/index.html>.



Google Earth



GPI Interim Site, formerly Vacublast (for GeoSyntec)
Abilene, Kansas

GPS Coordinates:

IRM Well: 38.91348, -97.22801
 KDHE MW-1: 38.91886, -97.23605
 KDHE MW-3: 38.92242, -97.23135
 MW-8: 38.92384, -97.23456
 MW-9: 38.92384, -97.23454
 MW-10: 38.92284, -97.23378
 MW-11: 38.92284, -97.23367
 MW-18: 38.92056, -97.23392

MW-21: 38.92006, -97.23402
 MW-22: 38.91990, -97.23294
 MW-23: 38.92058, -97.23049
 MW-27: 38.91863, -97.23015
 MW-28: 38.91863, -97.23001
 MW-29: 38.91632, -97.23053
 MW-30: 38.91632, -97.23039
 MW-31: 38.91540, -97.22569

GPI Interim Site, formerly Vacublast (for GeoSyntec)
Abilene, Kansas
Sheet 2

GPS Coordinates (cont'd):

MW-33: 38.91370, -97.22780
MW-34: 38.91118, -97.22841
MW-40: 38.91516, -97.23303
MW-41: 38.91232, -97.22749
MW-60: 38.91545, -97.22563
MW-71: 38.91529, -97.22939

MW-33BR: 38.91385, -97.22790
MW-39: 38.91516, -97.23289
MW-40: 38.91516, -97.23303
MW-42: 38.91233, -97.22732
MW-61: 38.91278, -97.22489
MW-72: 38.91537, -97.23044

RECEIVED
APR 1 1998
KS GEO SURVEY