

WATER WELL PLUGGING RECORD Form WWC-5P


KSA 82a-1212

ID NO.

PW-4

1 LOCATION OF WATER WELL: Fraction SW 1/4 NE 1/4 SW 1/4 Section Number 6 Township Number T 13 S Range Number 2 E W
 County Dickinson
 Street/Rural Address of Well Location; if unknown, distance & direction from nearest town or intersection. If at owner's address, check here Fair Road, between 2400 and 2500 Avenue
 Global Positioning Systems (GPS) information:
 Latitude: 38.94855949 (in decimal degrees)
 Longitude: 97.25617197 (in decimal degrees)
 Elevation: _____
 Horizontal Datum: WGS84, NAD83, NAD27
 Collection Method: _____

2 WATER WELL OWNER: RR#, St. Address, Box #: _____ City, State ZIP Code: _____
 GPS unit (Make/Model: Trimble Geopointer 400)
 Digital Map Photo, Topographic Map, Land Survey
 Est. Accuracy: < 3 m. 3-5 m. 5-15 m. > 15 m

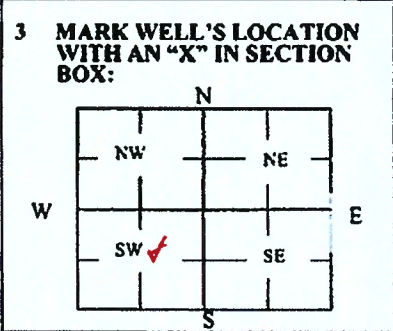

4 DEPTH OF WELL 77.7 ft. Type Riser
 WELL'S STATIC WATER LEVEL 37.5 ft.
 WELL WAS USED AS:
 Domestic Public Water Supply Dewatering
 Irrigation Oil Field Water Supply Monitoring
 Feedlot Domestic (Lawn & Garden) Injection Well
 Industrial Air Conditioning Other _____
 Was a chemical/bacteriological sample submitted to Department? Yes No

5 TYPE OF BLANK CASING USED:
 Steel RMP (SR) Wrought Fiberglass Other (Specify below)
 PVC ABS Asbestos-Cement Concrete Tile
 Blank casing diameter _____ in. Was casing pulled? Yes No If yes, how much _____
 Casing height above or below land surface _____ in.

6 GROUT PLUG MATERIAL: Neat cement Cement grout Bentonite Other Soil
 Grout Plug Intervals: From 77.7 ft. to 3 ft., From _____ ft. to _____ ft., From 3 ft. to 0 ft.
 What is the nearest source of possible contamination:
 Septic tank Seepage pit Fuel storage Other (specify below)
 Sewer lines Pit privy Fertilizer storage
 Watertight sewer lines Sewage lagoon Insecticide storage
 Lateral lines Feedyard Abandoned water well Direction from well? _____
 Cess pool Livestock pens Oil well/Gas well How many feet? _____

FROM	TO	PLUGGING MATERIALS	FROM	TO	PLUGGING MATERIALS
77.7	3	Neat Cement			
3	0	Soil			

7 CONTRACTOR'S OR LANDOWNER'S CERTIFICATION: This water well was plugged under my jurisdiction and was completed on (mo/day/year) 24 Aug 2021 and this record is true to the best of my knowledge and belief. Kansas Water Well Contractor's License No. _____ This Water Well Record was completed on (mo/day/year) 24 Aug 2021 under the business name of USAIE by (signature) _____

Send one white copy to Kansas Department of Health & Environment, Geology Section, 1006 SW Jackson Street, Ste. 420, Topeka, KS 66612-1367. Send one copy to WATER WELL OWNER and retain one for your records.
 Visit us at <http://www.kdheks.gov/waterwell/index.html> Telephone 785-296-5524.