

WATER WELL PLUGGING RECORD Form WWC-5P


KSA 82a-1212

ID NO.

MW-3

1 LOCATION OF WATER WELL: Fraction SW 1/4 NE 1/4 SW 1/4 SW 1/4 Section Number 6 Township Number T 13 S Range Number 2 E W
 County: Dickinson
 Street Rural Address of Well Location: if unknown, distance & direction from nearest town or intersection. If at owner's address, check here Fair Road, between 2400 and 2500 Avenue
Global Positioning Systems (GPS) information:
 Latitude: 38.94878415 (in decimal degrees)
 Longitude: -97.76564911 (in decimal degrees)
 Elevation: _____
 Horizontal Datum: WGS84, NAD83, NAD27
 Collection Method: _____

2 WATER WELL OWNER:
 RR#, St. Address, Box #: _____
 City, State ZIP Code: _____
 GPS unit (Make/Model: Trimble Geoexplorer 6000)
 Digital Map Photo Topographic Map Land Survey
 Est. Accuracy: < 3 m. 3-5 m. 5-15 m. > 15 m

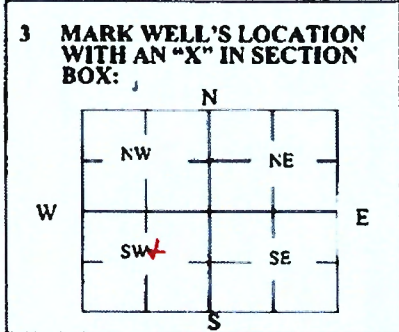

4 DEPTH OF WELL 72.6 ft. top of riser
 WELL'S STATIC WATER LEVEL 42.4 ft
 WELL WAS USED AS:
 Domestic Irrigation Feedlot Industrial
 Public Water Supply Oil Field Water Supply Domestic (Lawn & Garden) Air Conditioning
 Dewatering Monitoring Injection Well Other _____
 Was a chemical/bacteriological sample submitted to Department? Yes No

5 TYPE OF BLANK CASING USED:
 Steel RMP (SR) Wrought Fiberglass Other (Specify below)
 PVC ABS Asbestos-Cement Concrete Tile
 Blank casing diameter _____ in. Was casing pulled? Yes No If yes, how much _____
 Casing height above or below land surface _____ in.

6 GROUT PLUG MATERIAL: Neat cement Cement grout Bentonite Other Soil
 Grout Plug Intervals: From 72.6 ft. to 3 ft., From _____ ft. to _____ ft., From 3 ft. to 0 ft.
 What is the nearest source of possible contamination:
 Septic tank Sewer lines Watertight sewer lines Lateral lines Cess pool
 Seepage pit Pit privy Sewage lagoon Feedyard Livestock pens
 Fuel storage Fertilizer storage Insecticide storage Abandoned water well Oil well/Gas well
 Other (specify below) _____
 Direction from well? _____
 How many feet? _____

FROM	TO	PLUGGING MATERIALS	FROM	TO	PLUGGING MATERIALS
72.6	3	Neat Cement			
3	0	Soil			

7 CONTRACTOR'S OR LANDOWNER'S CERTIFICATION: This water well was plugged under my jurisdiction and was completed on (mo./day/year) 24 Aug 2021 and this record is true to the best of my knowledge and belief. Kansas Water Well Contractor's License No. _____ This Water Well Record was completed on (mo./day/year) 24 Aug 2021 under the business name of USACE by (signature) _____

Send one white copy to Kansas Department of Health & Environment, Geology Section, 1000 SW Jackson Street, Ste. 420, Topeka, KS 66612-1367. Send one copy to WATER WELL OWNER and retain one for your records.
 Visit us at <http://www.kdheks.gov/watervell/index.html> Telephone 785-296-5524