


1 LOCATION OF WATER WELL: Fraction NW 1/4 NW 1/4 NE 1/4 Section Number 19 Township Number T 13 S Range Number R 2 E

County: Dickinson Distance and direction from nearest town or city street address of well if located within city? 2 miles West of Hwy 15 in Abilene, Ks on West First St. & 1 block South

2 WATER WELL OWNER: Ralph Morton RR#, St. Address, Box #: 114 Westwood Dr. Board of Agriculture, Division of Water Resources City, State, ZIP Code: Abilene, Kansas 67410 Application Number:

3 LOCATE WELL'S LOCATION WITH AN "X" IN SECTION BOX:

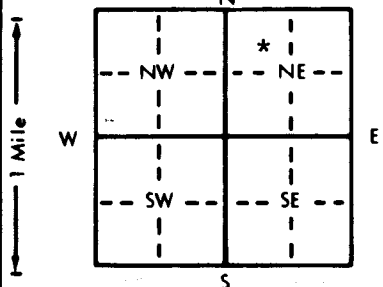

4 DEPTH OF COMPLETED WELL: 76 ft. ELEVATION: Depth(s) Groundwater Encountered 1. 48 ft. 2. ft. 3. ft. WELL'S STATIC WATER LEVEL: 35'6" ft. below land surface measured on mo/day/yr 4 / 7 / 95 Pump test data: Well water was ft. after hours pumping gpm Est. Yield 15+ gpm Well water was ft. after hours pumping gpm Bore Hole Diameter 9 in. to 76 ft., and in. to ft. WELL WATER TO BE USED AS: 5 Public water supply 8 Air conditioning 11 Injection well 1 Domestic 3 Feedlot 6 Oil field water supply 9 Dewatering 12 Other (Specify below) 2 Irrigation 4 Industrial 7 Lawn and garden only 10 Monitoring well Was a chemical/bacteriological sample submitted to Department? Yes No *; If yes, mo/day/yr sample was submitted Water Well Disinfected? Yes * No

5 TYPE OF BLANK CASING USED: 1 Steel 3 RMP (SR) 5 Wrought iron 8 Concrete tile CASING JOINTS: Glued * Clamped 2 PVC 4 ABS 6 Asbestos-Cement 9 Other (specify below) Welded Threaded

Blank casing diameter 5 in. to 76 ft., Dia in. to ft., Dia in. to ft. Casing height above land surface 24 in., weight 160 lbs./ft. Wall thickness or gauge No. 214

TYPE OF SCREEN OR PERFORATION MATERIAL: 1 Steel 3 Stainless steel 5 Fiberglass 8 RMP (SR) 10 Asbestos-cement 2 Brass 4 Galvanized steel 6 Concrete tile 9 ABS 12 None used (open hole)

SCREEN OR PERFORATION OPENINGS ARE: 1 Continuous slot 3 Mill slot 5 Gauzed wrapped 8 Saw cut 11 None (open hole) 2 Louvered shutter 4 Key punched 6 Wire wrapped 9 Drilled holes 7 Torch cut 10 Other (specify) ft.

SCREEN-PERFORATED INTERVALS: From 44 ft. to 76 ft., From ft. to ft. GRAVEL PACK INTERVALS: From 24 ft. to 76 ft., From ft. to ft.

6 GROUT MATERIAL: 1 Neat cement 2 Cement grout 3 Bentonite 4 Other Grout Intervals: From 1 ft. to 24 ft., From ft. to ft., From ft. to ft.

What is the nearest source of possible contamination: 1 Septic tank 4 Lateral lines 7 Pit privy 10 Livestock pens 14 Abandoned water well 2 Sewer lines 5 Cess pool 8 Sewage lagoon 11 Fuel storage 15 Oil well/Gas well 3 Watertight sewer lines 6 Seepage pit 9 Feedyard 12 Fertilizer storage 16 Other (specify below) 13 Insecticide storage Direction from well? SOUTHEAST How many feet? 85

FROM	TO	LITHOLOGIC LOG	FROM	TO	PLUGGING INTERVALS
0	1	DARK SANDY TOP SOIL			
1	8	BROWN SANDY CLAY			
8	11	BROWN CLAY			
11	19	LITE COLOR CLAY			
19	20	LITE COLOR LIMESTONE			
20	24	LITE COLOR CLAY			
24	26	LITE GRAY CLAY			
26	41	RED CLAY			
41	45	LITE GRAY SHALE * CLAY			
45	62	LITE COLOR LIMESTONE			
62	71	GRAY LIMESTONE			
71	76	GRAY SHALE & CLAY			

7 CONTRACTOR'S OR LANDOWNER'S CERTIFICATION: This water well was (1) constructed, (2) reconstructed, or (3) plugged under my jurisdiction and was completed on (mo/day/year) 4 / 7 / 95 and this record is true to the best of my knowledge and belief. Kansas Water Well Contractor's License No. 397 This Water Well Record was completed on (mo/day/yr) 4 / 12 / 95 under the business name of CENTRAL KANSAS DRILLING by (signature) Harold D. Martin

INSTRUCTIONS: Use typewriter or ball point pen. PLEASE PRESS FIRMLY and PRINT clearly. Please fill in blanks, underline or circle the correct answers. Send top three copies to Kansas Department of Health and Environment, Bureau of Water, Topeka, Kansas 66620-0001. Telephone: 913-296-5545. Send one to WATER WELL OWNER and retain one for your records.

000400