


OFFICE USE ONLY T R E/W SEC. 1/4 1/4 1/4

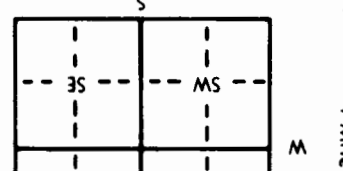

Bore Hole Diameter: 8 3/4 in. to 20 ft. and 7 1/8 in. to 213 ft.
 WELL WATER TO BE USED AS:
 1 Domestic (circled)
 3 Feedlot
 6 Oil field water supply
 9 Dewatering
 12 Other (Specify below)
 11 Injection well
 10 Monitoring well
 7 Lawn and garden only
 4 Industrial
 2 Irrigation
 Was a chemical/bacteriological sample submitted to Department? Yes No
 Was a chemical/bacteriological sample submitted to Department? Yes No
 Water Well Disinfected? Yes No
 Clamped
 Glued
 Welded

5 TYPE OF BLANK CASING USED:
 5 Wrought iron
 8 Concrete tile
 3 RMP (SR)
 4 ABS
 2 PVC (circled)
 5" (circled)
 193 (circled)
 36 (circled)
 193 (circled)
 7 Fiberglass
 6 Asbestos-Cement
 9 Other (specify below)
 Threaded

TYPE OF SCREEN OR PERFORMANCE MATERIAL:
 1 Steel
 3 Stainless steel
 5 Fiberglass
 8 RMP (SR)
 7 PVC (circled)
 10 Asbestos-cement
 11 Other (specify)
 12 None used (open hole)



GRAVEL PACK INTERVALS:
 1 Neat cement
 2 Cement grout
 3 Bentonite (circled)
 4 Other
 10 Livestock pens
 11 Fuel storage
 15 Oil well/Gas well
 16 Other (specify below)
 3 Water-tight sewer lines
 5 Cess pool
 8 Sewage lagoon
 9 Feedyard
 13 Insecticide storage
 14 Abandoned water well


What is the nearest source of possible contamination:
 1 Septic tank
 4 Lateral lines
 7 Pit privy
 8 Sewage lagoon
 9 Feedyard
 13 Insecticide storage
 14 Abandoned water well
 15 Oil well/Gas well
 16 Other (specify below)

FROM	TO	LITHOLOGIC LOG	FROM	TO	PLUGGING INTERVALS
0	16	Soil/clay			
16	65	Shale			
65	71	Lime			
71	81	Shale			
81	87	Lime sand			
87	95	Silty shale			
95	117	Shale			
117	119	Lime			
119	141	Shale			
141	146	Silty sand & shale laminated			
146	157	Shale			
157	157	Lime sand - HARDI			
157	166	Lime sand & shale laminated			
166	166	Sand coarse graind			

7 CONTRACTOR'S OR LANDOWNER'S CERTIFICATION: This water well was (1) constructed (2) reconstructed, or (3) plugged under my jurisdiction and was completed on (mo./day/year) 3-22-94
 Water Well Contractor's License No. 561
 This Water Well Record was completed on (mo./day/yr) 3-22-94
 by (signature) *Scott E. E...*
 under the business name of *Evans Energy Dev. Inc.*
 INSTRUCTIONS: Use typewriter or ball point pen. PLEASE PRESS FIRMLY and PRINT clearly. Please fill in blanks, underline or circle the correct answers. Send top three copies to Kansas Department of Health and Environment, Bureau of Water, Topeka, Kansas 66620-0001. Telephone: 913-296-5545. Send one to WATER WELL OWNER and retain one for your records.


1/4 1/4 1/4

1 LOCATION OF WATER WELL: County: Douglas Fraction: SW 1/4 NW 1/4 NE 1/4 Section Number: 36 Township Number: T 13 S Range Number: R 20 EW

Distance and direction from nearest town or city street address of well if located within city? 3 miles South of Lawrence and 1/2 East on South

2 WATER WELL OWNER: Ken Lassman
 RR#, St. Address, Box #: 603 N. 3rd
 City, State, ZIP Code: Lawrence KS. 66044
 Board of Agriculture, Division of Water Resources
 Application Number:

3 LOCATE WELL'S LOCATION WITH AN "X" IN SECTION BOX:

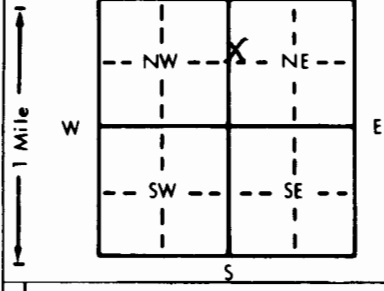

4 DEPTH OF COMPLETED WELL: 213 ft. ELEVATION:

Depth(s) Groundwater Encountered 1. 166-213 ft. 2. ft. 3. ft.
 WELL'S STATIC WATER LEVEL 13.5 ft. below land surface measured on mo/day/yr 3-22-94
 Pump test data: Well water was ft. after hours pumping gpm
 Est. Yield 30 gpm: Well water was ft. after hours pumping gpm
 Bore Hole Diameter: 8 3/4 in. to 20 ft., and 7 7/8 in. to 213 ft.
 WELL WATER TO BE USED AS:
 1 Domestic 3 Feedlot 6 Oil field water supply 9 Dewatering 12 Other (Specify below)
 2 Irrigation 4 Industrial 7 Lawn and garden only 10 Monitoring well
 Was a chemical/bacteriological sample submitted to Department? Yes.....No.....; If yes, mo/day/yr sample was submitted
 Water Well Disinfected? Yes No

5 TYPE OF BLANK CASING USED: 5 Wrought iron 8 Concrete tile CASING JOINTS: Glued Clamped
 1 Steel 3 RMP (SR) 6 Asbestos-Cement 9 Other (specify below) Welded
 2 PVC 4 ABS 7 Fiberglass Threaded

Blank casing diameter: 5" in. to 193 ft., Dia. in. to ft., Dia. in. to ft.
 Casing height above land surface: 36 in., weight lbs./ft. Wall thickness or gauge No.

TYPE OF SCREEN OR PERFORATION MATERIAL:
 1 Steel 3 Stainless steel 5 Fiberglass 7 PVC 10 Asbestos-cement
 2 Brass 4 Galvanized steel 6 Concrete tile 8 RMP (SR) 11 Other (specify)
 9 ABS 12 None used (open hole)

SCREEN OR PERFORATION OPENINGS ARE:
 1 Continuous slot 3 Mill slot 5 Gauzed wrapped 8 Saw cut 11 None (open hole)
 2 Louvered shutter 4 Key punched 6 Wire wrapped 9 Drilled holes
 7 Torch cut 10 Other (specify)

SCREEN-PERFORATED INTERVALS: From: 193 ft. to 213 ft., From ft. to ft.
 GRAVEL PACK INTERVALS: From: 20 ft. to 213 ft., From ft. to ft.

6 GROUT MATERIAL: 1 Neat cement 2 Cement grout 3 Bentonite 4 Other
 Grout Intervals: From: 0 ft. to 20 ft., From ft. to ft., From ft. to ft.

What is the nearest source of possible contamination: NONE at the time
 1 Septic tank 4 Lateral lines 7 Pit privy 10 Livestock pens 14 Abandoned water well
 2 Sewer lines 5 Cess pool 8 Sewage lagoon 11 Fuel storage 15 Oil well/Gas well
 3 Watertight sewer lines 6 Seepage pit 9 Feedyard 12 Fertilizer storage 16 Other (specify below)
 13 Insecticide storage

Direction from well? How many feet?

FROM	TO	LITHOLOGIC LOG	FROM	TO	PLUGGING INTERVALS
0	16	Soil + Clay			
16	65	Shale			
65	71	Lime			
71	81	Shale			
81	87	Limey Sand			
87	95	Silty shale			
95	117	Shale			
117	119	Lime			
119	141	Shale			
141	146	Silty Sand & Shale Laminated			
146	157	Shale			
157	157	Limey Sand - HARD!			
157	166	Sand & Shale Laminated			
166	213	Sand Coarse grained			

7 CONTRACTOR'S OR LANDOWNER'S CERTIFICATION: This water well was (1) constructed (2) reconstructed, or (3) plugged under my jurisdiction and was completed on (mo/day/year) 3-22-94 and this record is true to the best of my knowledge and belief. Kansas Water Well Contractor's License No. 561 This Water Well Record was completed on (mo/day/yr) 3-22-94 under the business name of EVANS Every Dev. Inc. by (signature) Jeff P. Evans