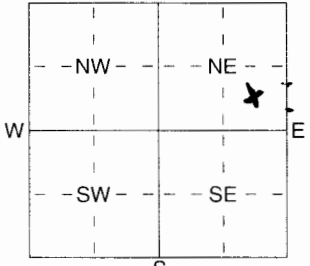


1 LOCATION OF WATER WELL: Fraction SE 1/4 SE 1/4 NE 1/4 Section Number 30 Township Number T 13 S Range Number R 20 E/W  
 County: Douglas

Distance and direction from nearest town or city street address of well if located within city?  
3.3 miles S on 1500<sup>th</sup> from 23<sup>rd</sup> St. Lawrence, ks. Fairview Estates #2 Lot 2 Block

2 WATER WELL OWNER: Frank and Carolyn Stagg Douglas Permits # 1371  
 RR#, St. Address, Box #: 2309 Paris Drive  
 City, State, ZIP Code: Tracy MI. 48083  
 Board of Agriculture, Division of Water Resource  
 Application Number:

3 LOCATE WELL'S LOCATION WITH AN "X" IN SECTION BOX:  
  
 4 DEPTH OF COMPLETED WELL 158 ft. ELEVATION:  
 Depth(s) Groundwater Encountered 1 100-157 ft. 2 ..... ft. 3 ..... ft.  
 WELL'S STATIC WATER LEVEL 91 ft. below land surface measured on mo/day/yr 9-30-04  
 Pump test data: Well water was ..... ft. after ..... hours pumping ..... gpm  
 Est. Yield 15 gpm: Well water was ..... ft. after ..... hours pumping ..... gpm  
 WELL WATER TO BE USED AS:  
 Domestic 3 Feedlot 6 Oil field water supply 9 Dewatering 12 Other (Specify below)  
 2 Irrigation 4 Industrial 7 Domestic (lawn & garden) 10 Monitoring well  
 Was a chemical/bacteriological sample submitted to Department? Yes ..... No X; If yes, mo/day/yr sample was submitted  
 Water Well Disinfected? Yes X No

5 TYPE OF BLANK CASING USED:  
 1 Steel 3 RMP (SR) 5 Wrought iron 8 Concrete tile CASING JOINTS: Glued X Clamped .....  
 2 PVC 4 ABS 7 Fiberglass 9 Other (specify below) Welded .....  
 Blank casing diameter 5 in. to 148 ft. Dia ..... in. to ..... ft. Dia ..... in. to ..... ft.  
 Casing height above land surface 30 in., weight 50R.21 200PSI lbs./ft. Wall thickness or gauge No. ....  
 TYPE OF SCREEN OR PERFORATION MATERIAL:  
 1 Steel 3 Stainless Steel 5 Fiberglass 8 RMP (SR) 10 Asbestos-Cement  
 2 Brass 4 Galvanized Steel 6 Concrete tile 9 ABS 11 Other (Specify) .....  
 12 None used (open hole)  
 SCREEN OR PERFORATION OPENINGS ARE:  
 1 Continuous slot 3 Mill slot 5 Gauzed wrapped 8 Saw cut 11 None (open hole)  
 2 Louvered shutter 4 Key punched 6 Wire wrapped 9 Drilled holes  
 7 Torch cut 10 Other (specify) .....  
 SCREEN-PERFORATED INTERVALS: From 148 ft. to 158 ft. From ..... ft. to ..... ft.  
 GRAVEL PACK INTERVALS: From 158 ft. to 84 ft. From 66 ft. to 40 ft.

6 GROUT MATERIAL: 1 Neat cement 2 Cement grout 3 Bentonite 4 Other .....  
 Grout Intervals: From 0 ft. to 40 ft. From 66 ft. to 84 ft. From ..... ft. to ..... ft.  
 What is the nearest source of possible contamination:  
 1 Septic tank  4 Lateral lines 7 Pit privy 11 Fuel storage 14 Abandoned water well  
 2 Sewer lines 5 Cess pool 8 Sewage lagoon 12 Fertilizer storage 15 Oil well/Gas well  
 3 Watertight sewer lines 6 Seepage pit 9 Feedyard 13 Insecticide storage 16 Other (specify below)  
 Direction from well? North How many feet? 100+ feet

| FROM | TO  | LITHOLOGIC LOG         | FROM | TO | PLUGGING INTERVALS |
|------|-----|------------------------|------|----|--------------------|
| 0    | 10  | Clay                   |      |    |                    |
| 10   | 22  | yellow sandstone       |      |    |                    |
| 22   | 27  | Limestone              |      |    |                    |
| 27   | 29  | yellow sandstone       |      |    |                    |
| 29   | 78  | grey sandstone + shale |      |    | RECEIVED           |
| 78   | 82  | Limestone              |      |    | OCT 13 2004        |
| 82   | 84  | Shale                  |      |    |                    |
| 84   | 90  | fine grained sandstone |      |    | BUREAU OF WATER    |
| 90   | 108 | Shale                  |      |    |                    |
| 108  | 116 | Sandstone + shale      |      |    |                    |
| 116  | 157 | Sandstone              |      |    |                    |
| 157  | 158 | Limestone              |      |    |                    |

7 CONTRACTOR'S OR LANDOWNER'S CERTIFICATION: This water well was  (1) constructed, (2) reconstructed, or (3) plugged under my jurisdiction and was completed on (mo/day/year) 9-30-04 and this record is true to the best of my knowledge and belief. Kansas Water Well Contractor's Licence No 561 This Water Well Record was completed on (mo/day/yr) 10-4-04 under the business name of Evans Energy Dev. Inc. by (signature) [Signature]