


1 LOCATION OF WATER WELL: Fraction NW¹/₄ NW¹/₄ NE¹/₄ Section Number 4 Township Number 13S Range Number 20 DW
 County: Douglas

Distance and direction from nearest town or city street address of well if located within city?

1608 N1400 Rd Lawrence KS

2 WATER WELL OWNER: FI Kansas Remediation Trust
 RR#, St. Address, Box #: 1608 N1400 Rd
 City, State ZIP Code: Lawrence, KS 66201
Global Positioning Systems (decimal degrees, min. of 4 digits)
 Latitude: 38.951248948
 Longitude: -95.185922893
 Elevation: _____
 Datum: _____
 Data Collection Method: _____

3 MARK WELL'S LOCATION WITH AN "X" IN SECTION BOX:

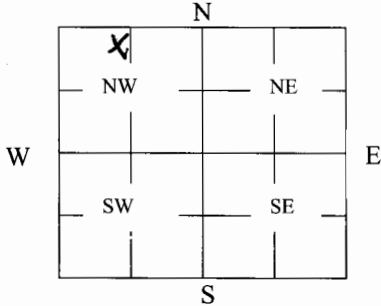

4 DEPTH OF WELL 52 ft. SW04
WELL'S STATIC WATER LEVEL 32'4 ft

WELL WAS USED AS:

- | | | |
|--|----------------------------|-------------------|
| 1 Domestic | 5 Public Water Supply | 9 Dewatering |
| 2 Irrigation | 6 Oil Field Water Supply | 10 Monitoring |
| 3 Feedlot | 7 Domestic (Lawn & Garden) | 11 Injection Well |
| <input checked="" type="checkbox"/> 4 Industrial | 8 Air Conditioning | 12 Other _____ |

Was a chemical/bacteriological sample submitted to Department? Yes _____ No _____

5 TYPE OF BLANK CASING USED:
 1 Steel 3 RMP (SR) 5 Wrought 7 Fiberglass 9 Other (Specify below) _____
 2 PVC 4 ABS 6 Asbestos-Cement 8 Concrete Tile

Blank casing diameter 16 in. Was casing pulled? Yes No _____ If yes, how much 6'
 Casing height above or below land surface 38 in.

6 GROUT PLUG MATERIAL: 1 Neat cement 2 Cement grout 3 Bentonite 4 Other _____
 Grout Plug Intervals: From 52 ft. to 3 ft., From _____ ft. to _____ ft., From _____ to _____ ft.

What is the nearest source of possible contamination:

- | | | | |
|--------------------------|-------------------|---|--------------------------------|
| 1 Septic tank | 6 Seepage pit | 11 Fuel Storage | 16 Other (specify below) _____ |
| 2 Sewer lines | 7 Pit privy | <input checked="" type="checkbox"/> 12 Fertilizer storage | _____ |
| 3 Watertight sewer lines | 8 Sewage lagoon | 13 Insecticide storage | _____ |
| 4 Lateral lines | 9 Feedyard | 14 Abandoned water well | Direction from well? _____ |
| 5 Cess pool | 10 Livestock pens | 15 Oil well/Gas well | How many feet? _____ |

FROM	TO	PLUGGING MATERIALS	FROM	TO	PLUGGING MATERIALS
0	52	Bentonite			
52	0	Soil			

7 CONTRACTOR'S OR LANDOWNER'S CERTIFICATION: This water well was plugged under my jurisdiction and was completed on (mo/day/year) 2-20-07 and this record is true to the best of my knowledge and belief. Kansas Water Well Contractor's License No. 704. This Water Well Record was completed on (mo/day/year) 2-20-07 under the business name of maxs by (signature) David Rump