WATER WELL PLUGGING RECORD Form WWC-5P KSA 82a-1212 ID NO.

1 LOCATION OF WATER WELL: County: Douglas	Fraction: NE¼ SW¼ NE¼	Section Number: 4	Township Number: 13 S	Range Number: 20 (E) W

Distance and direction from nearest town or city street address of well if located within city?

1608 N 1400 St Lawrence

2 WATER WELL OWNER: FI Kansas Remediation Trust

RR#, St. Address, Box #: 1608 N 1400 St

City, State ZIP Code: Lawrence ks 66701

Global Positioning Systems (decimal degrees, min. of 4 digits)
Latitude: 38.68241 2400
Longitude: -95.87492 1503
Elevation:
Datum:
Data Collection Method:

3 MARK WELL'S LOCATION WITH AN "X" IN SECTION BOX:

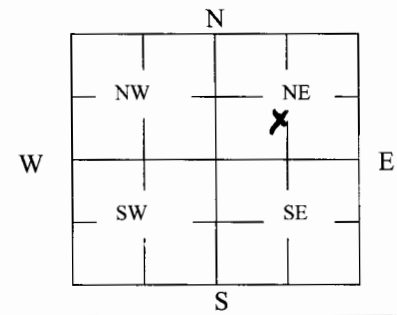

4 DEPTH OF WELL 60 ft. PSW-06B-RW2

WELL'S STATIC WATER LEVEL 33 ft

WELL WAS USED AS:

1 Domestic	5 Public Water Supply	(9) Dewatering
2 Irrigation	6 Oil Field Water Supply	10 Monitoring
3 Feedlot	7 Domestic (Lawn & Garden)	11 Injection Well
4 Industrial	8 Air Conditioning	12 Other

Was a chemical/bacteriological sample submitted to Department? Yes ____ No X

5 TYPE OF BLANK CASING USED:

1 Steel	3 RMP (SR)	5 Wrought	7 Fiberglass	9 Other (Specify below)
(2) PVC	4 ABS	6 Asbestos-Cement	8 Concrete Tile	

Blank casing diameter 6 in. Was casing pulled? Yes X No ____ If yes, how much 17'

Casing height above or below land surface 24 in.

6 GROUT PLUG MATERIAL: 1 Neat cement 2 Cement grout (3) Bentonite 4 Other

Grout Plug Intervals: From 60 ft. to 2 ft., From ____ ft. to ____ ft., From ____ to ____ ft.

What is the nearest source of possible contamination:

1 Septic tank	6 Seepage pit	11 Fuel Storage	16 Other (specify below)
2 Sewer lines	7 Pit privy	(12) Fertilizer storage	
3 Watertight sewer lines	8 Sewage lagoon	13 Insecticide storage	
4 Lateral lines	9 Feedyard	14 Abandoned water well	Direction from well?
5 Cess pool	10 Livestock pens	15 Oil well/Gas well	How many feet?

FROM	TO	PLUGGING MATERIALS	FROM	TO	PLUGGING MATERIALS
~~0~~	~~25~~	~~Bentonite~~			
60	2	Bentonite			
2	0	Soil			

7 CONTRACTOR'S OR LANDOWNER'S CERTIFICATION: This water well was plugged under my jurisdiction and was completed on (mo/day/year) 2-23-07 and this record is true to the best of my knowledge and belief. Kansas Water Well Contractor's License No. 704. This Water Well Record was completed on (mo/day/year) 2-23-07 under the business name of MAS by (signature) David Hunyh

INSTRUCTIONS: Use typewriter or ballpoint pen. Please press firmly and print clearly. Please fill in blanks, underline or circle the correct answers. Send top three copies to Kansas Department of Health and Environment, Bureau of Water, Geology Section, 1000 SW Jackson St., Ste. 420, Topeka, Kansas 66612-1367. Telephone: 785/296-5522. Send one to Water Well Owner and retain one for your records. Visit us at http://www.kdheks.gov/geo/waterwells.