


1 LOCATION OF WATER WELL: Fraction NW₄ SW NE₄ Section Number 4 Township Number 13S Range Number 20E
 County: Douglas

Distance and direction from nearest town or city street address of well if located within city?
1608 W 1400 Rd Lawrence, ks

2 WATER WELL OWNER: FI Kansas Remediation Trust
 RR#, St. Address, Box #: 1608 W 1400 Rd
 City, State ZIP Code: Lawrence, ks 66704

Global Positioning Systems (decimal degrees, min. of 4 digits)
 Latitude: 38.976053308
 Longitude: -95.188402371
 Elevation: _____
 Datum: _____
 Data Collection Method: _____

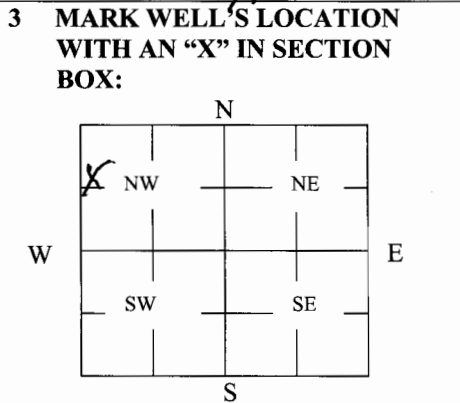

4 DEPTH OF WELL 10 ft. PW 16 ME P16
 WELL'S STATIC WATER LEVEL dry ft.
 WELL WAS USED AS:
 1 Domestic 5 Public Water Supply 9 Dewatering
 2 Irrigation 6 Oil Field Water Supply 10 Monitoring
 3 Feedlot 7 Domestic (Lawn & Garden) 11 Injection Well
 4 Industrial 8 Air Conditioning 12 Other _____

Was a chemical/bacteriological sample submitted to Department? Yes _____ No _____

5 TYPE OF BLANK CASING USED:
 1 Steel 3 RMP (SR) 5 Wrought 7 Fiberglass 9 Other (Specify below)
 2 PVC 4 ABS 6 Asbestos-Cement 8 Concrete Tile

Blank casing diameter 4 in. Was casing pulled? Yes > No _____ If yes, how much ALL
 Casing height above or below land surface 12 in.

6 GROUT PLUG MATERIAL: 1 Neat cement 2 Cement grout 3 Bentonite 4 Other _____

Grout Plug Intervals: From 9 ft. to _____ ft., From _____ ft. to _____ ft., From _____ to _____ ft.

What is the nearest source of possible contamination:

1 Septic tank 6 Seepage pit 11 Fuel Storage 16 Other (specify below) _____
 2 Sewer lines 7 Pit privy 2 Fertilizer storage _____
 3 Watertight sewer lines 8 Sewage lagoon 13 Insecticide storage _____
 4 Lateral lines 9 Feedyard 14 Abandoned water well Direction from well? _____
 5 Cess pool 10 Livestock pens 15 Oil well/Gas well How many feet? _____

FROM	TO	PLUGGING MATERIALS	FROM	TO	PLUGGING MATERIALS
9	1	Bentonite			
1	0	SOIL			

7 CONTRACTOR'S OR LANDOWNER'S CERTIFICATION: This water well was plugged under my jurisdiction and was completed on (mo/day/year) 2-19-07 and this record is true to the best of my knowledge and belief. Kansas Water Well Contractor's License No. 209. This Water Well Record was completed on (mo/day/year) 2-19-07 under the business name of Maxis by (signature) David Dwyer