


**1 LOCATION OF WATER WELL:**  
 County: Douglas Fraction NW<sub>4</sub> SW<sub>4</sub> NE<sub>4</sub> Section Number 41 Township Number 13S Range Number 20

Distance and direction from nearest town or city street address of well if located within city?  
1608 N 1400 RD Lawrence, KS

**2 WATER WELL OWNER:**  
FI Kansas Remediation Trust  
 RR#, St. Address, Box #: 1608 W 1400 RD  
 City, State ZIP Code: Lawrence, KS 66201

**Global Positioning Systems (decimal degrees, min. of 4 digits)**  
 Latitude: 38.946053308  
 Longitude: -95.188402371  
 Elevation: \_\_\_\_\_  
 Datum: \_\_\_\_\_  
 Data Collection Method: \_\_\_\_\_

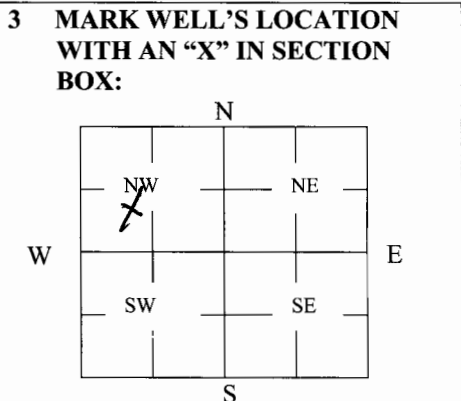

**4 DEPTH OF WELL** 10 ft. P 17  
 WELL'S STATIC WATER LEVEL DRY ft.  
 WELL WAS USED AS:  
 1 Domestic                      5 Public Water Supply                      9 Dewatering  
 2 Irrigation                      6 Oil Field Water Supply                      10 Monitoring  
 3 Feedlot                          7 Domestic (Lawn & Garden)                      11 Injection Well  
 4 Industrial                      8 Air Conditioning                          12 Other \_\_\_\_\_  
 Was a chemical/bacteriological sample submitted to Department? Yes \_\_\_\_\_ No Yes

**5 TYPE OF BLANK CASING USED:**  
 1 Steel                      3 RMP (SR)                      5 Wrought                      7 Fiberglass                      9 Other (Specify below)  
 2 PVC                      4 ABS                          6 Asbestos-Cement                      8 Concrete Tile

Blank casing diameter 4 in. Was casing pulled? Yes No \_\_\_\_\_ If yes, how much ALL  
 Casing height above or below land surface 12 in.

**6 GROUT PLUG MATERIAL:**      1 Neat cement      2 Cement grout      3 Bentonite      4 Other \_\_\_\_\_

Grout Plug Intervals: From 9 ft. to 7 ft., From \_\_\_\_\_ ft. to \_\_\_\_\_ ft., From \_\_\_\_\_ to \_\_\_\_\_ ft.

What is the nearest source of possible contamination:  
 1 Septic tank                      6 Seepage pit                      11 Fuel Storage                      16 Other (specify below)  
 2 Sewer lines                      7 Pit privy                      12 Fertilizer storage  
 3 Watertight sewer lines                      8 Sewage lagoon                      13 Insecticide storage  
 4 Lateral lines                      9 Feedyard                      14 Abandoned water well                      Direction from well? \_\_\_\_\_  
 5 Cess pool                      10 Livestock pens                      15 Oil well/Gas well                      How many feet? \_\_\_\_\_

FROM	TO	PLUGGING MATERIALS	FROM	TO	PLUGGING MATERIALS
<u>9</u>	<u>1</u>	<u>Bentonite</u>			
<u>1</u>	<u>0</u>	<u>Soil</u>			

**7 CONTRACTOR'S OR LANDOWNER'S CERTIFICATION:** This water well was plugged under my jurisdiction and was completed on (mo/day/year) 2-6-07 and this record is true to the best of my knowledge and belief. Kansas Water Well Contractor's License No. 704. This Water Well Record was completed on (mo/day/year) 2-6-07 under the business name of Moss by (signature) David Bunch

**INSTRUCTIONS:** Use typewriter or ballpoint pen. Please press firmly and print clearly. Please fill in blanks, underline or circle the correct answers. Send top three copies to Kansas Department of Health and Environment, Bureau of Water, Geology Section, 1000 SW Jackson St., Ste. 420, Topeka, Kansas 66612-1367. Telephone: 785/296-5522. Send one to Water Well Owner and retain one for your records. Visit us at <http://www.kdheks.gov/geo/waterwells>.