


**1 LOCATION OF WATER WELL:** Fraction SE<sup>1</sup>/<sub>4</sub> SW<sup>1</sup>/<sub>4</sub> NE<sup>1</sup>/<sub>4</sub> Section Number 4 Township Number 13S Range Number 20 EW  
 County: Douglas

Distance and direction from nearest town or city street address of well if located within city?

1608 N 1400 Rd Lawrence, KS

**2 WATER WELL OWNER:** FI Kansas Remediation Trust RR#, St. Address, Box #: 1608 N 1400 Rd & Lawrence, KS 66046  
**Global Positioning Systems** (decimal degrees, min. of 4 digits)  
 Latitude: 38.944464533  
 Longitude: -95.187811464  
 Elevation: 850  
 Datum: \_\_\_\_\_  
 Data Collection Method: \_\_\_\_\_

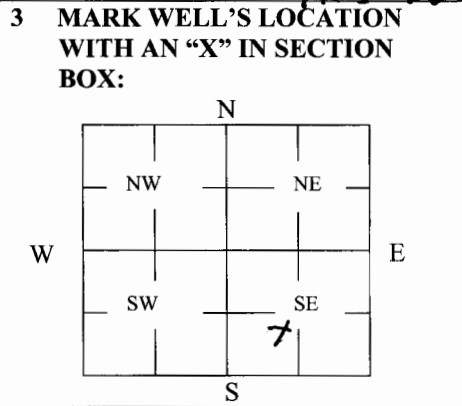

**4 DEPTH OF WELL** 23 ft. PSW08  
**WELL'S STATIC WATER LEVEL** 13' ft  
**WELL WAS USED AS:**  
 1 Domestic                      5 Public Water Supply                      9 Dewatering  
 2 Irrigation                      6 Oil Field Water Supply                      10 Monitoring  
 3 Feedlot                          7 Domestic (Lawn & Garden)                      11 Injection Well  
 4 Industrial                      8 Air Conditioning                          12 Other \_\_\_\_\_  
 Was a chemical/bacteriological sample submitted to Department? Yes \_\_\_\_\_ No X

**5 TYPE OF BLANK CASING USED:**  
 1 Steel                      3 RMP (SR)                      5 Wrought                      7 Fiberglass                      9 Other (Specify below)  
 2 PVC                      4 ABS                          6 Asbestos-Cement                      8 Concrete Tile  
 Blank casing diameter 2 in. Was casing pulled? Yes ✓ No \_\_\_\_\_ If yes, how much 23'  
 Casing height above or below land surface 29 in.

**6 GROUT PLUG MATERIAL:** 1 Neat cement                      2 ○ Cement grout                      3 Bentonite                      4 Other \_\_\_\_\_  
 Grout Plug Intervals: From 20 1/4 ft. to 2 ft., From \_\_\_\_\_ ft. to \_\_\_\_\_ ft., From \_\_\_\_\_ to \_\_\_\_\_ ft.

What is the nearest source of possible contamination:  
 1 Septic tank                      6 Seepage pit                      11 Fuel Storage                      16 Other (specify below)  
 2 Sewer lines                      7 Pit privy                          12 Fertilizer storage  
 3 Watertight sewer lines                      8 Sewage lagoon                      13 Insecticide storage  
 4 Lateral lines                      9 Feedyard                          14 Abandoned water well                      Direction from well? \_\_\_\_\_  
 5 Cess pool                      10 Livestock pens                      15 Oil well/Gas well                      How many feet? \_\_\_\_\_

FROM	TO	PLUGGING MATERIALS	FROM	TO	PLUGGING MATERIALS
<u>20 1/4</u>	<u>2</u>	<u>Bentonite</u>			
<u>2</u>	<u>0</u>	<u>Soil</u>			

**7 CONTRACTOR'S OR LANDOWNER'S CERTIFICATION:** This water well was plugged under my jurisdiction and was completed on (mo/day/year) 1-23-07 and this record is true to the best of my knowledge and belief. Kansas Water Well Contractor's License No. 704. This Water Well Record was completed on (mo/day/year) 1-23-07 under the business name of maxs by (signature) David Hunter