


**1 LOCATION OF WATER WELL:** Fraction NW 1/4 NW 1/4 NW 1/4 Section Number 4 Township Number 13S Range Number 20 EW  
 County: Douglas

Distance and direction from nearest town or city street address of well if located within city?

1608 N 1400 Rd Lawrence, ks

**2 WATER WELL OWNER:** PI Kansas Remediation trust  
 RR#, St. Address, Box #: 1608 N 1400 Rd  
 City, State ZIP Code: Lawrence ks 66046  
 Global Positioning Systems (decimal degrees, min. of 4 digits)  
 Latitude: 38.951532495  
 Longitude: -95.195169723  
 Elevation: 520  
 Datum: \_\_\_\_\_  
 Data Collection Method: \_\_\_\_\_

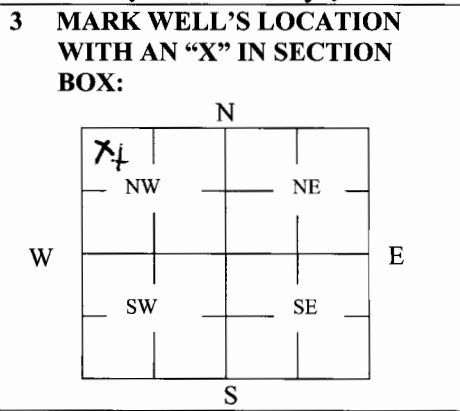

**4 DEPTH OF WELL** 19 ft. OW 19  
 WELL'S STATIC WATER LEVEL 12'9 ft  
 WELL WAS USED AS:  
 1 Domestic 5 Public Water Supply 9 Dewatering  
 2 Irrigation 6 Oil Field Water Supply 10  Monitoring  
 3 Feedlot 7 Domestic (Lawn & Garden) 11 Injection Well  
 4 Industrial 8 Air Conditioning 12 Other \_\_\_\_\_  
 Was a chemical/bacteriological sample submitted to Department? Yes \_\_\_\_\_ No

**5 TYPE OF BLANK CASING USED:**  
 1 Steel 3 RMP (SR) 5 Wrought 7 Fiberglass 9 Other (Specify below)  
 PVC 4 ABS 6 Asbestos-Cement 8 Concrete Tile  
 Blank casing diameter 3 in. Was casing pulled? Yes  No \_\_\_\_\_ If yes, how much 19'  
 Casing height above or below land surface 36 in.

**6 GROUT PLUG MATERIAL:** 1 Neat cement 2 Cement grout  3 Bentonite 4 Other \_\_\_\_\_  
 Grout Plug Intervals: From 16 ft. to 6" ft., From \_\_\_\_\_ ft. to \_\_\_\_\_ ft., From \_\_\_\_\_ to \_\_\_\_\_ ft.

What is the nearest source of possible contamination:  
 1 Septic tank 6 Seepage pit 11 Fuel Storage 16 Other (specify below)  
 2 Sewer lines 7 Pit privy  10 Fertilizer storage  
 3 Watertight sewer lines 8 Sewage lagoon 13 Insecticide storage  
 4 Lateral lines 9 Feedyard 14 Abandoned water well Direction from well? \_\_\_\_\_  
 5 Cess pool 10 Livestock pens 15 Oil well/Gas well How many feet? \_\_\_\_\_

FROM	TO	PLUGGING MATERIALS	FROM	TO	PLUGGING MATERIALS
<u>16"</u>	<u>6"</u>	<u>Bentonite</u>			
<u>6"</u>	<u>0</u>	<u>Soil</u>			

**7 CONTRACTOR'S OR LANDOWNER'S CERTIFICATION:** This water well was plugged under my jurisdiction and was completed on (mo/day/year) 1-24-07 and this record is true to the best of my knowledge and belief. Kansas Water Well Contractor's License No. 704. This Water Well Record was completed on (mo/day/year) 1-24-07 under the business name of maxs by (signature) David Hengler