WATER WELL PLUGGING RECORD **Form WWC-5P** **KSA 82a-1212** **ID NO.**

1 LOCATION OF WATER WELL: County: Douglas	Fraction NW¼ SE¼ NW¼	Section Number 4	Township Number 13 S	Range Number 20 E/W

Distance and direction from nearest town or city street address of well if located within city?
1608 N 1400 Rd Lawrence Ks

2 WATER WELL OWNER: FI Kansas Remediation trust
RR#, St. Address, Box #: 1608 N 1401 Rd
City, State ZIP Code: Lawrence Ks 66046

Global Positioning Systems (decimal degrees, min. of 4 digits
Latitude: 38.947005588
Longitude: -95.190794471
Elevation: 845
Datum:
Data Collection Method:

3 MARK WELL'S LOCATION WITH AN "X" IN SECTION BOX:

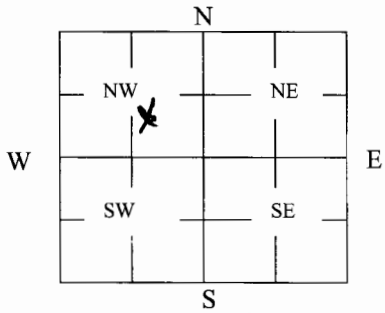

4 DEPTH OF WELL 19 ft. HAM SMWIN

WELL'S STATIC WATER LEVEL 9'8 ft

WELL WAS USED AS:

1 Domestic	5 Public Water Supply	9 Dewatering
2 Irrigation	6 Oil Field Water Supply	(10) Monitoring
3 Feedlot	7 Domestic (Lawn & Garden)	11 Injection Well
4 Industrial	8 Air Conditioning	12 Other _____

Was a chemical/bacteriological sample submitted to Department? Yes ____ No X

5 TYPE OF BLANK CASING USED:

1 Steel	3 RMP (SR)	5 Wrought	7 Fiberglass	9 Other (Specify below)
2 PVC	4 ABS	6 Asbestos-Cement	8 Concrete Tile	

Blank casing diameter 2 in. Was casing pulled? Yes X No ____ If yes, how much ALL
Casing height above or below land surface 24 in.

6 GROUT PLUG MATERIAL: 1 Neat cement 2 Cement grout (3) Bentonite 4 Other _____

Grout Plug Intervals: From 19 ft. to 2 ft., From ____ ft. to ____ ft., From ____ to ____ ft.

What is the nearest source of possible contamination:

1 Septic tank	6 Seepage pit	11 Fuel Storage	16 Other (specify below)
2 Sewer lines	7 Pit privy	(12) Fertilizer storage	
3 Watertight sewer lines	8 Sewage lagoon	13 Insecticide storage	
4 Lateral lines	9 Feedyard	14 Abandoned water well	Direction from well? ____
5 Cess pool	10 Livestock pens	15 Oil well/Gas well	How many feet? ____

FROM	TO	PLUGGING MATERIALS	FROM	TO	PLUGGING MATERIALS
19	2	Bentonite			
2	0	Soil			

7 CONTRACTOR'S OR LANDOWNER'S CERTIFICATION: This water well was plugged under my jurisdiction and was completed on (mo/day/year) 1-22-07 and this record is true to the best of my knowledge and belief. Kansas Water Well Contractor's License No. 707. This Water Well Record was completed on (mo/day/year) 1-22-07 under the business name of Mars by (signature) Daniel Smith.

INSTRUCTIONS: Use typewriter or ballpoint pen. Please press firmly and print clearly. Please fill in blanks, underline or circle the correct answers. Send top three copies to Kansas Department of Health and Environment, Bureau of Water, Geology Section, 1000 SW Jackson St., Ste. 420, Topeka, Kansas 66612-1367. Telephone: 785/296-5522. Send one to Water Well Owner and retain one for your records. Visit us at http://www.kdheks.gov/geo/waterwells.