


1 LOCATION OF WATER WELL:
 County: Douglas Fraction SE 1/4 SE 1/4 NW 1/4 Section Number 4 Township Number 13 S Range Number 20 W

Distance and direction from nearest town or city street address of well if located within city?

1608 N 1400 Rd

2 WATER WELL OWNER:
FE Kansas Remediation Trust
 RR#, St. Address, Box #: 1608 N1400 Rd
 City, State ZIP Code: Lawrence, KS 66701

Global Positioning Systems (decimal degrees, min. of 4 digits)
 Latitude: _____
 Longitude: _____
 Elevation: _____
 Datum: _____
 Data Collection Method: _____

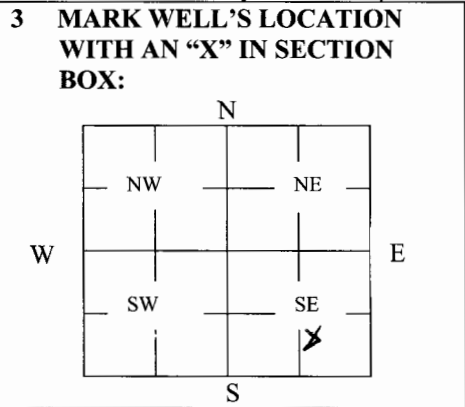

4 DEPTH OF WELL 10 ft. P13
 WELL'S STATIC WATER LEVEL Dry ft
 WELL WAS USED AS:
 1 Domestic 2 Irrigation 3 Feedlot 4 Industrial 5 Public Water Supply 6 Oil Field Water Supply 7 Domestic (Lawn & Garden) 8 Air Conditioning 9 Dewatering 10 Monitoring 11 Injection Well 12 Other _____
 Was a chemical/bacteriological sample submitted to Department? Yes _____ No ✓

5 TYPE OF BLANK CASING USED:
 1 Steel 2 PVC 3 RMP (SR) 4 ABS 5 Wrought 6 Asbestos-Cement 7 Fiberglass 8 Concrete Tile 9 Other (Specify below) _____
 Blank casing diameter 4 in. Was casing pulled? Yes ✓ No _____ If yes, how much ALL
 Casing height above or below land surface 1 in.

6 GROUT PLUG MATERIAL: 1 Neat cement 2 Cement grout 3 Bentonite 4 Other _____
 Grout Plug Intervals: From 9 ft. to 1 ft., From _____ ft. to _____ ft., From _____ to _____ ft.
 What is the nearest source of possible contamination:
 1 Septic tank 2 Sewer lines 3 Watertight sewer lines 4 Lateral lines 5 Cess pool 6 Seepage pit 7 Pit privy 8 Sewage lagoon 9 Feedyard 10 Livestock pens 11 Fuel Storage 12 Fertilizer storage 13 Insecticide storage 14 Abandoned water well 15 Oil well/Gas well 16 Other (specify below) _____
 Direction from well? _____
 How many feet? _____

FROM	TO	PLUGGING MATERIALS	FROM	TO	PLUGGING MATERIALS
<u>9</u>	<u>1</u>	<u>Bentonite</u>			
<u>1</u>	<u>0</u>	<u>Soil</u>			

7 CONTRACTOR'S OR LANDOWNER'S CERTIFICATION: This water well was plugged under my jurisdiction and was completed on (mo/day/year) 2-19-07 and this record is true to the best of my knowledge and belief. Kansas Water Well Contractor's License No. 707. This Water Well Record was completed on (mo/day/year) 2-19-07 under the business name of Maxis by (signature) David Hough

INSTRUCTIONS: Use typewriter or ballpoint pen. Please press firmly and print clearly. Please fill in blanks, underline or circle the correct answers. Send top three copies to Kansas Department of Health and Environment, Bureau of Water, Geology Section, 1000 SW Jackson St., Ste. 420, Topeka, Kansas 66612-1367. Telephone: 785/296-5522. Send one to Water Well Owner and retain one for your records. Visit us at <http://www.kdheks.gov/geo/waterwells>.