


1 LOCATION OF WATER WELL:
 County: Douglas Fraction SE 1/4 SE 1/4 NW 1/4 Section Number 4 Township Number 13S Range Number 20 EW

Distance and direction from nearest town or city street address of well if located within city?

1608 N 1400 Rd Lawrence, KS

2 WATER WELL OWNER:
FI Kansas Remediation trust
 RR#, St. Address, Box #: 1608 N 1400 Rd
 City, State ZIP Code: Lawrence KS 66046
Global Positioning Systems (decimal degrees, min. of 4 digits)
 Latitude: 38.745586192
 Longitude: -95.189059305
 Elevation: _____
 Datum: _____
 Data Collection Method: _____

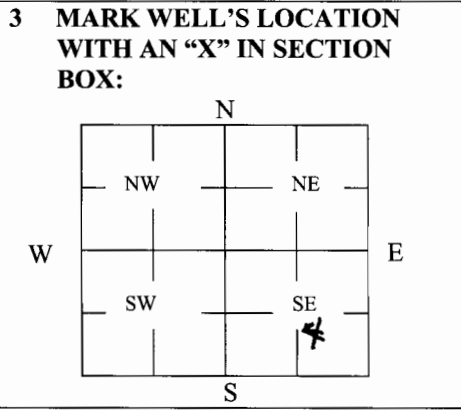

4 DEPTH OF WELL 19.5 ft. DW13
WELL'S STATIC WATER LEVEL 15' ft.
WELL WAS USED AS:
 1 Domestic 5 Public Water Supply 9 Dewatering
 2 Irrigation 6 Oil Field Water Supply ~~10~~ Monitoring
 3 Feedlot 7 Domestic (Lawn & Garden) 11 Injection Well
 4 Industrial 8 Air Conditioning 12 Other _____
 Was a chemical/bacteriological sample submitted to Department? Yes _____ No X

5 TYPE OF BLANK CASING USED:
 1 Steel 3 RMP (SR) 5 Wrought 7 Fiberglass 9 Other (Specify below) _____
 2 PVC 4 ABS 6 Asbestos-Cement 8 Concrete Tile _____
 Blank casing diameter 3 in. Was casing pulled? Yes No _____ If yes, how much 19.5
 Casing height above or below land surface 40 in.

6 GROUT PLUG MATERIAL: 1 Neat cement 2 Cement grout 3 Bentonite 4 Other _____
 Grout Plug Intervals: From 16 ft. to 6" ft., From _____ ft. to _____ ft., From _____ to _____ ft.

What is the nearest source of possible contamination:
 1 Septic tank 6 Seepage pit 11 Fuel Storage 16 Other (specify below) _____
 2 Sewer lines 7 Pit privy ~~12~~ Fertilizer storage _____
 3 Watertight sewer lines 8 Sewage lagoon 13 Insecticide storage _____
 4 Lateral lines 9 Feedyard 14 Abandoned water well Direction from well? _____
 5 Cess pool 10 Livestock pens 15 Oil well/Gas well How many feet? _____

FROM	TO	PLUGGING MATERIALS	FROM	TO	PLUGGING MATERIALS
<u>16'</u>	<u>6"</u>	<u>Bentonite</u>			
<u>6"</u>	<u>0</u>	<u>SOIL</u>			

7 CONTRACTOR'S OR LANDOWNER'S CERTIFICATION: This water well was plugged under my jurisdiction and was completed on (mo/day/year) 1-24-07 and this record is true to the best of my knowledge and belief. Kansas Water Well Contractor's License No. 704. This Water Well Record was completed on (mo/day/year) 1-24-07 under the business name of MAXS by (signature) David Huxler